H.B.M.16010

WATER SERVICE RECORD

Name J. Frank Buss **Service No.**

Address 9 Pheasant Lane

Location Lot #10

Repair—Renewal—New Service Glynn #1425 Lucente #782

Date		Material	Amount		Total		Date			Amount	
5/24/68	46'	3/4"Copper tubing									
8-1-69	40'	3/4" Copper tubing									

DATE _____

TOWN OF LEXINGTON — BOARD OF PUBLIC WORKS

WATER DIVISION

Sketch of Service Here

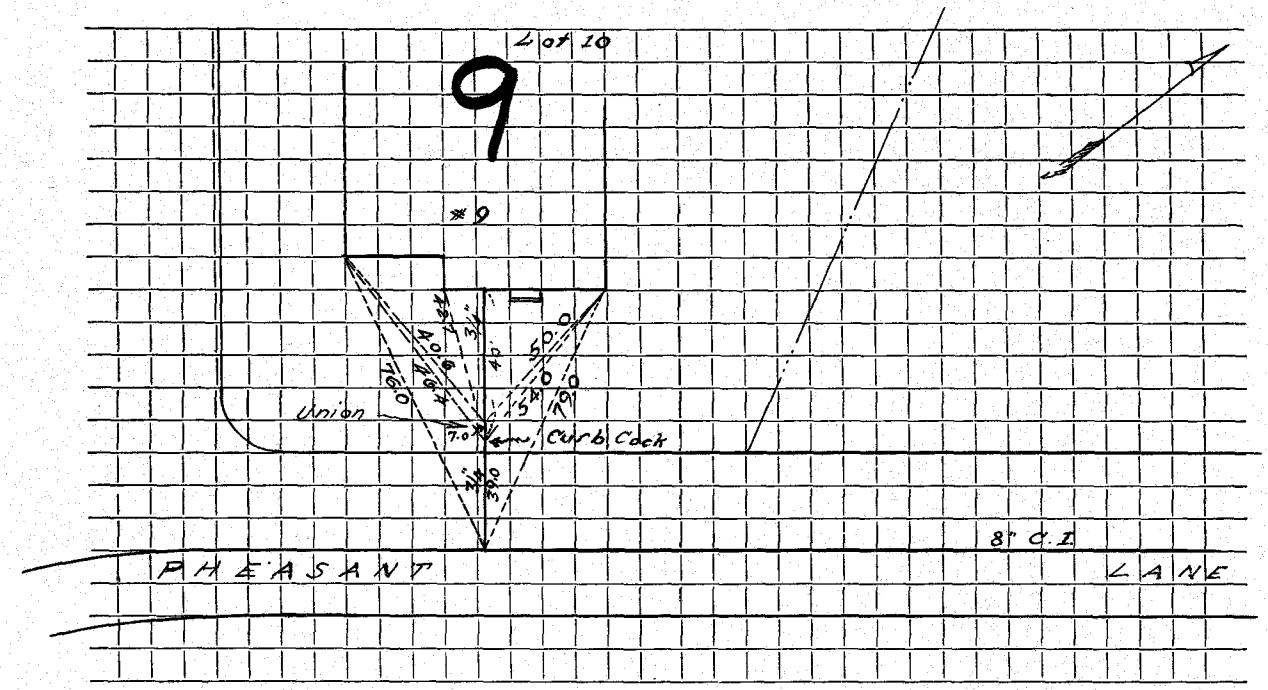

Connection made in ..... Street. Work completed .....

Remarks: .....

.....

.....