WATER SERVICE RECORD

Name *Robert E. Phelan* Service No.

Address #7 PHILBROOK TERRACE LOT #4

Location

Repair—Renewal—New Service *Redmond #4648*

Date		Material	Amount		Total		Date			Amount	
5/16/88		40.5 LF 1" COPPER									

DATE _____

TOWN OF LEXINGTON — BOARD OF PUBLIC WORKS

WATER DIVISION

Sketch of Service Here

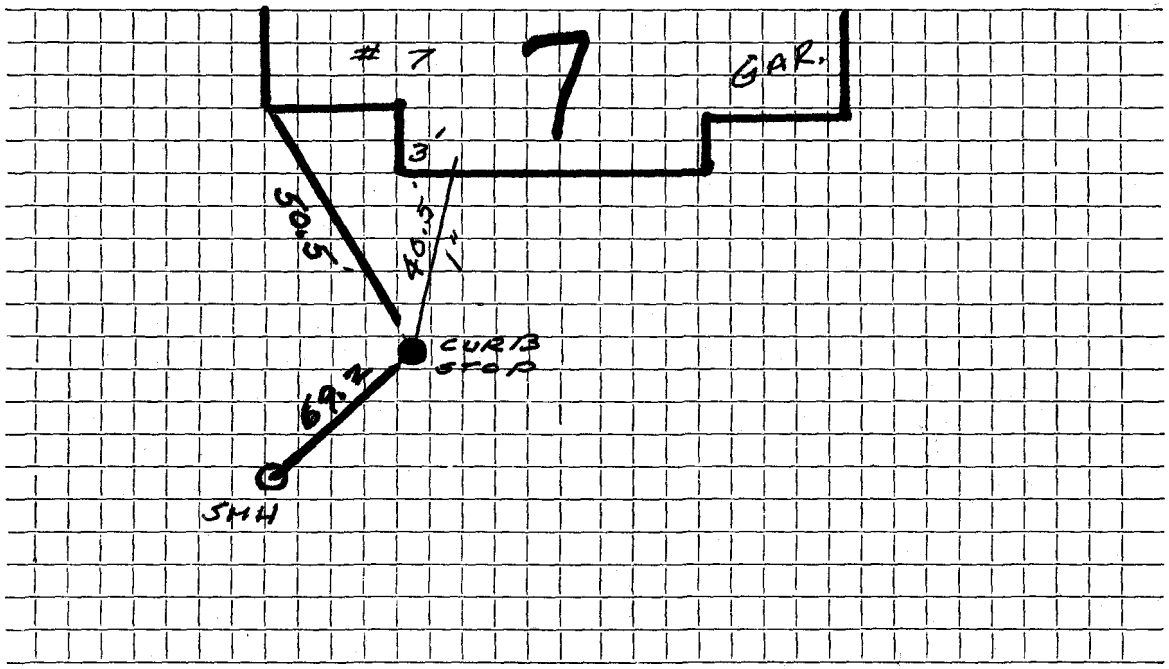

1

Connection made in PHILBROOK TERRACE Street. Work completed .....

Remarks: NO OUTSIDE TIES

SUBDIVISION