H.B.M.16010

#822

WATER SERVICE RECORD

Name Duffy Const. Co.

Service No. #7271

Address ~~XXXXXXXXXXXXXXXX~~ 39 Philip Road

Location Lot #222

~~Repair Renewal~~ **New Service** John J.Flannery Permit #A86

Date		Material	Amount		Total		Date			Amount	
11/12/66	66.5'	3/4" Copper tubing									

DATE _____

TOWN OF LEXINGTON — BOARD OF PUBLIC WORKS

WATER DIVISION

Sketch of Service Here

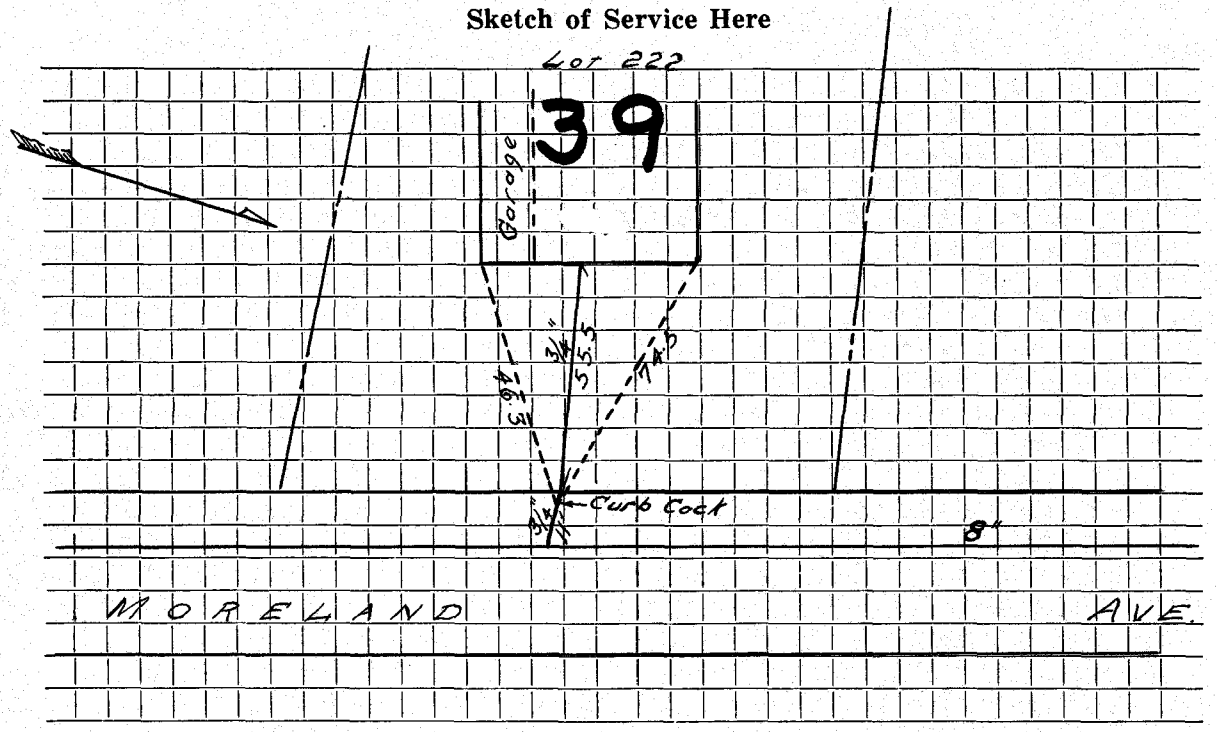

Connection made in ..... Street. Work completed .....

Remarks: .....

.....

.....