H.B.M.16010

WATER SERVICE RECORD

Name Duffy Const. Co. **Service No.**

Address ~~XXXXXXXXXXXXXXXX 61 Moreland Avenue~~ 41 Philip Road

Location Lot #223

~~Repair Renewal~~ **New Service** Flannery Permit #A87

Date		Material	Amount		Total		Date			Amount	
11/12/65	20'	3/4" Copper tubing									
	63'	3/4" Copper tubing									

DATE _____

TOWN OF LEXINGTON — BOARD OF PUBLIC WORKS

WATER DIVISION

Sketch of Service Here

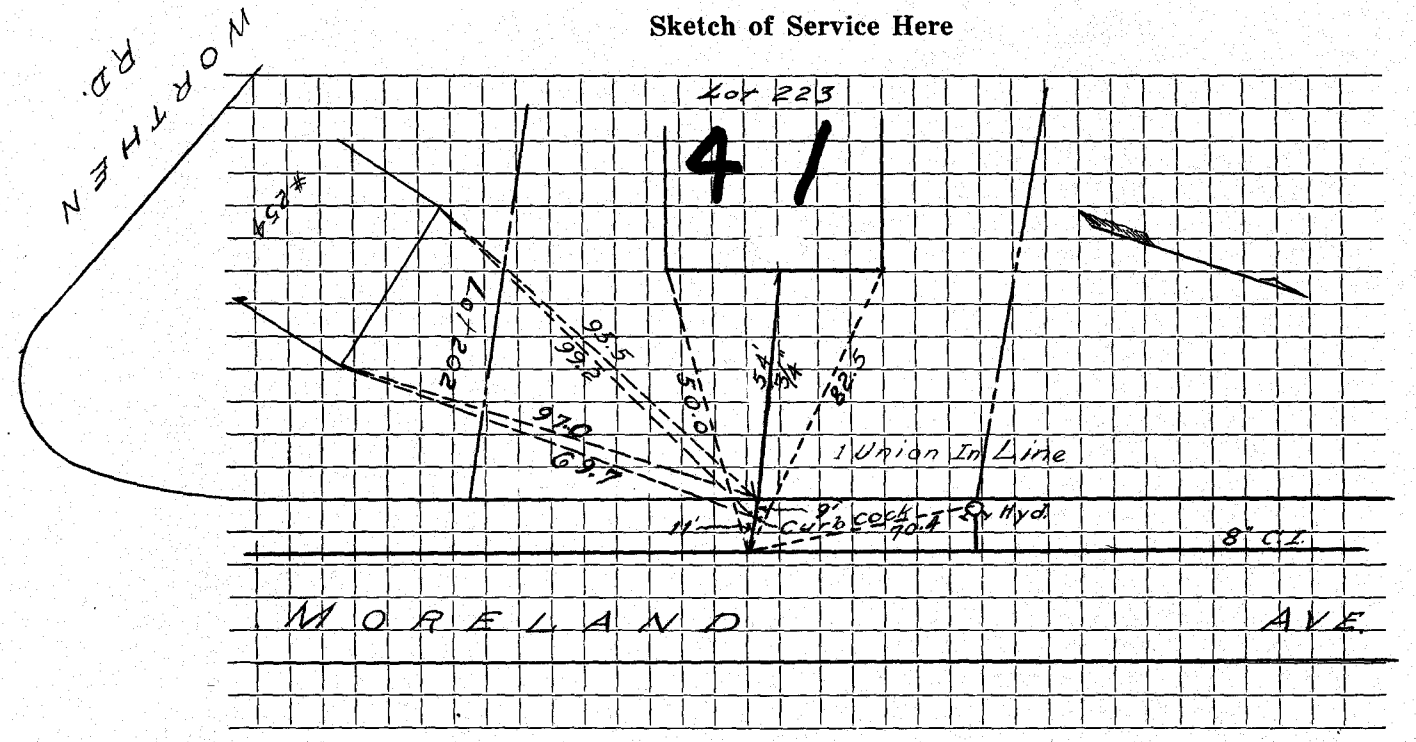

Connection made in ..... Street. Work completed .....

Remarks: .....

.....

.....