H.B.M.16010

WATER SERVICE RECORD

Name Pelham Const. Inc. **Service No.**

Address 17 Phinney Road

Location

Repair—Renewal—New Service DeFlice #1292

Date		Material	Amount		Total		Date			Amount	
3-30-69	56'	3/4" Copper tubing									

DATE _____

TOWN OF LEXINGTON — BOARD OF PUBLIC WORKS

WATER DIVISION

Sketch of Service Here

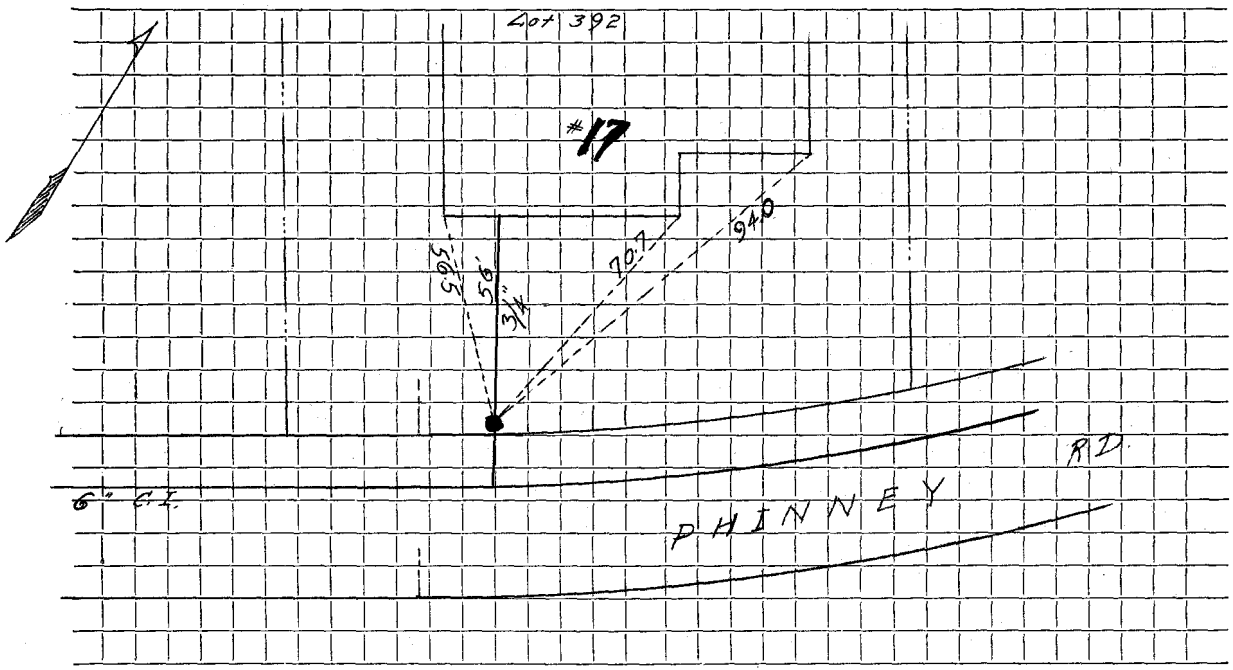

Connection made in ..... Street. Work completed .....

Remarks: .....

.....

.....