H.B.M.16010

2267

WATER SERVICE RECORD

Name

Service No.

Address 20 Phinney Road

Location

Repair—Renewal—New Service DeFlice #1170

Date		Material	Amount		Total		Date			Amount	

DATE _____

TOWN OF LEXINGTON — BOARD OF PUBLIC WORKS

WATER DIVISION

Sketch of Service Here

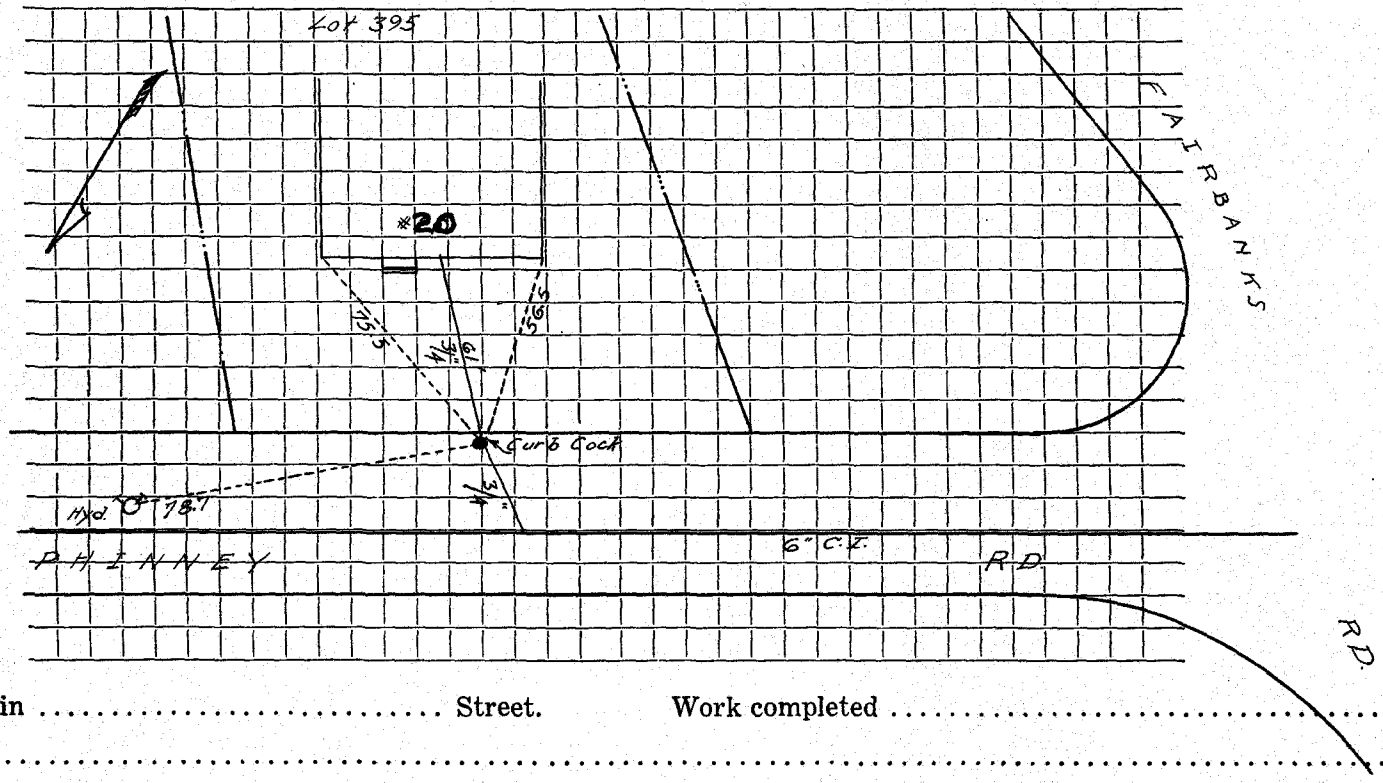

Connection made in ..... Street. Work completed .....

Remarks: .....

.....

.....