WATER SERVICE RECORD

Name JEFF GUO

Service No.

Address 10 PINE KNOLL ROAD

Location

Repair—Renewal—New Service TEAR DOWN. PERMIT # 1496

Date	Material	Amount	Total	Date		Amount
1-28-2001	1" COPPER FROM CURB BOX TO HOUSE					

DATE 1-8-2001

TOWN OF LEXINGTON — BOARD OF PUBLIC WORKS

WATER DIVISION

Sketch of Service Here

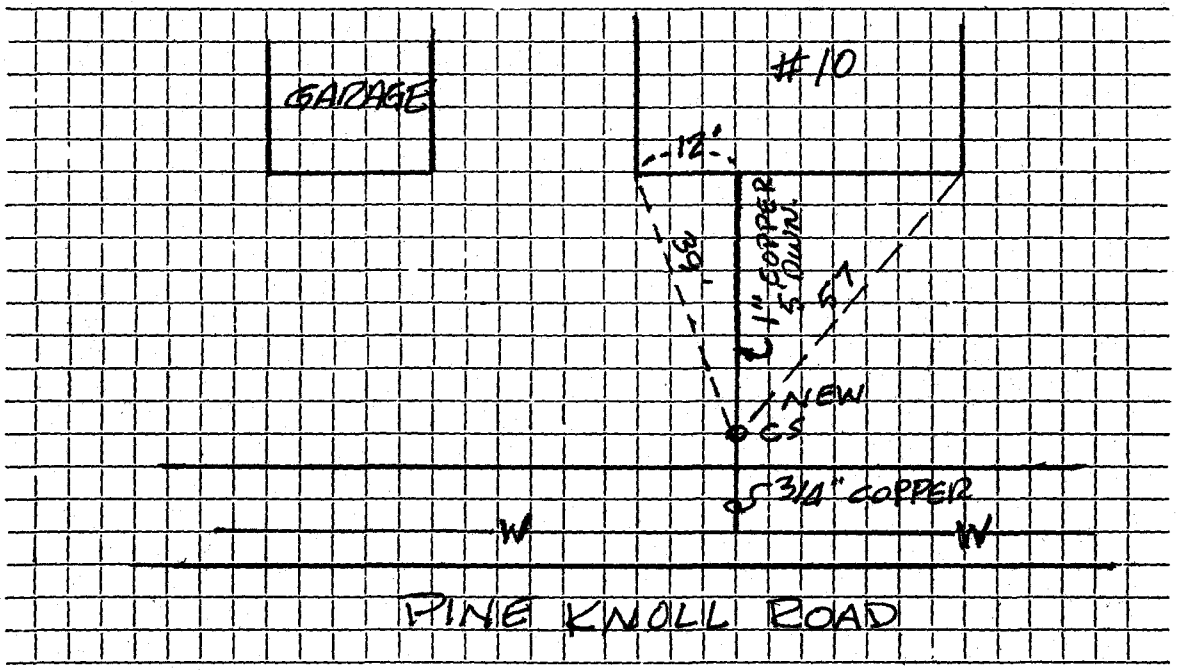

Connection made in PINE KNOLL RD. Street. Work completed RALPH SURIANELLO

Remarks: