WATER SERVICE RECORD

Name

Service No. 2862

Address 10 Piper Rd

Location

LOT 78

Repair—Renewal—New Service J McLaughlin

Date		Material	Amount	Total	Date		Sinclair	Amount
7/2/08	206'	1" Copper			7/2/08	27'	1" Copper	
	2	1" Unions				1	1" Corp	
						1	1" Curb Stop	
							box & lock	

DATE _____

TOWN OF LEXINGTON — BOARD OF PUBLIC WORKS

WATER DIVISION

Sketch of Service Here

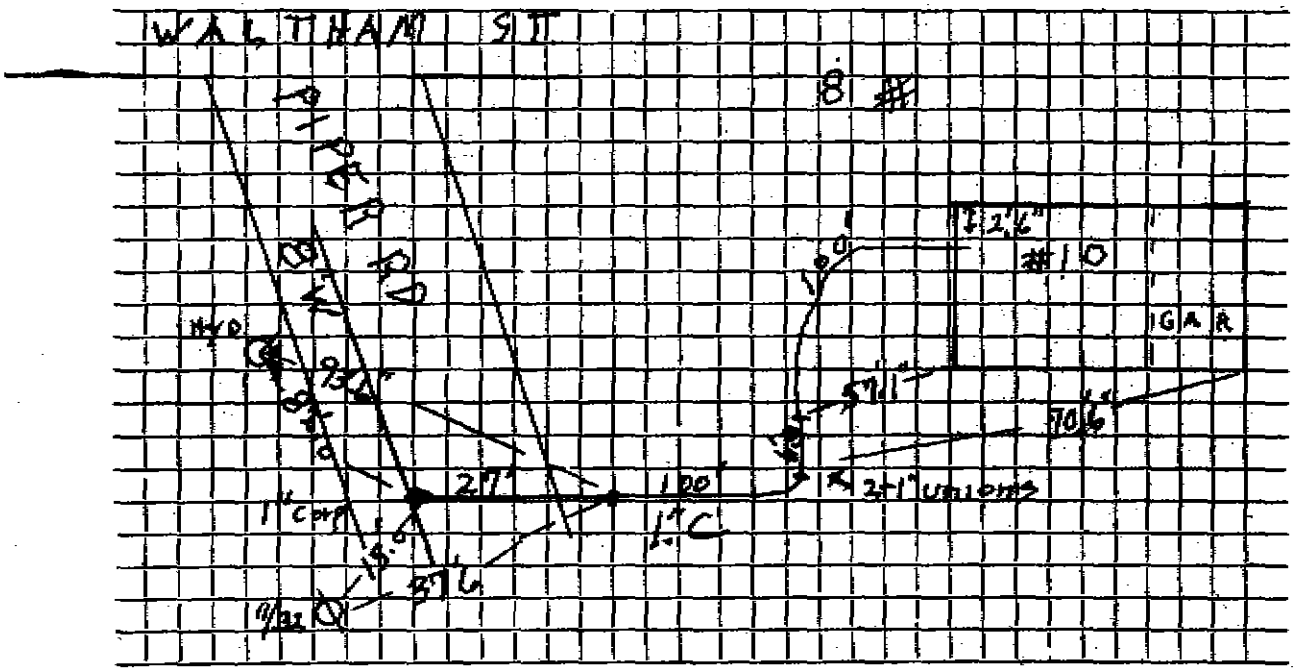

Connection made in ..... Street. Work completed 7/3/08 J. McLaughlin

Remarks: .....