# WATER SERVICE RECORD

**Name** **Service No.**

**Address**

**Location** PORTER LA

**Repair—Renewal—New Service** MCLAUGHLIN - WINDERMERE-PAT AUSTIN

| Date | | Material | Amount | | Total | | Date | | | Amount | |
|---|---|---|---|---|---|---|---|---|---|---|---|
| 12/9/98 | 1 | 12X8 TS+G | | | | | | | | | |
| | 1 | GATE BOX | | | | | | | | | |

DATE _____

TOWN OF LEXINGTON — BOARD OF PUBLIC WORKS

# WATER DIVISION

Sketch of Service Here

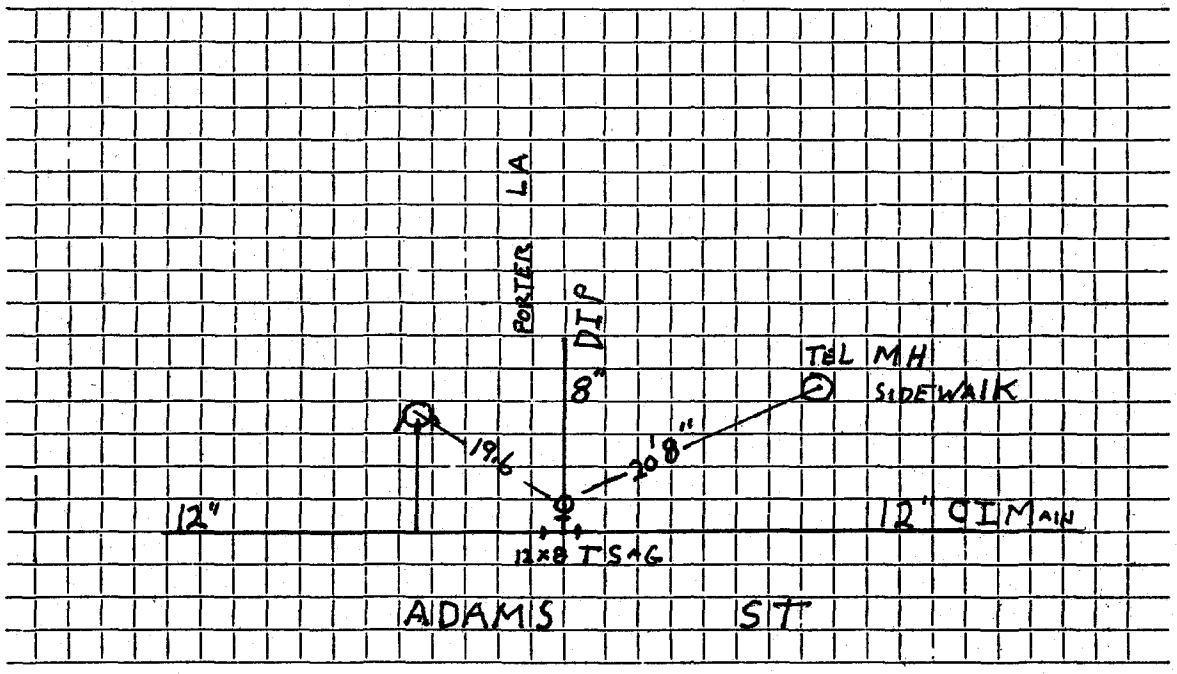


Connection made in ADAMS Street. Work completed .....

Remarks: .....