WATER SERVICE RECORD

Name

Service No.

Address 45 Ridge Road

Location

~~Repair~~ Renewal ~~New Service~~ Trebino

Date		Material	Amount	Total	Date			Amount
7/28/81	95'	3/4" Copper tubing						
	1	3/4" 3 part union						
	1	3/4" Stop & Waste						
							OUTSIDE	
					7/28/81	8'	3/4" Copper tubing	
						1	3/4" Corporation	
						1	3/4" Curb Stop	
						1	Box & Rod	

DATE_____

TOWN OF LEXINGTON — BOARD OF PUBLIC WORKS

WATER DIVISION

Sketch of Service Here

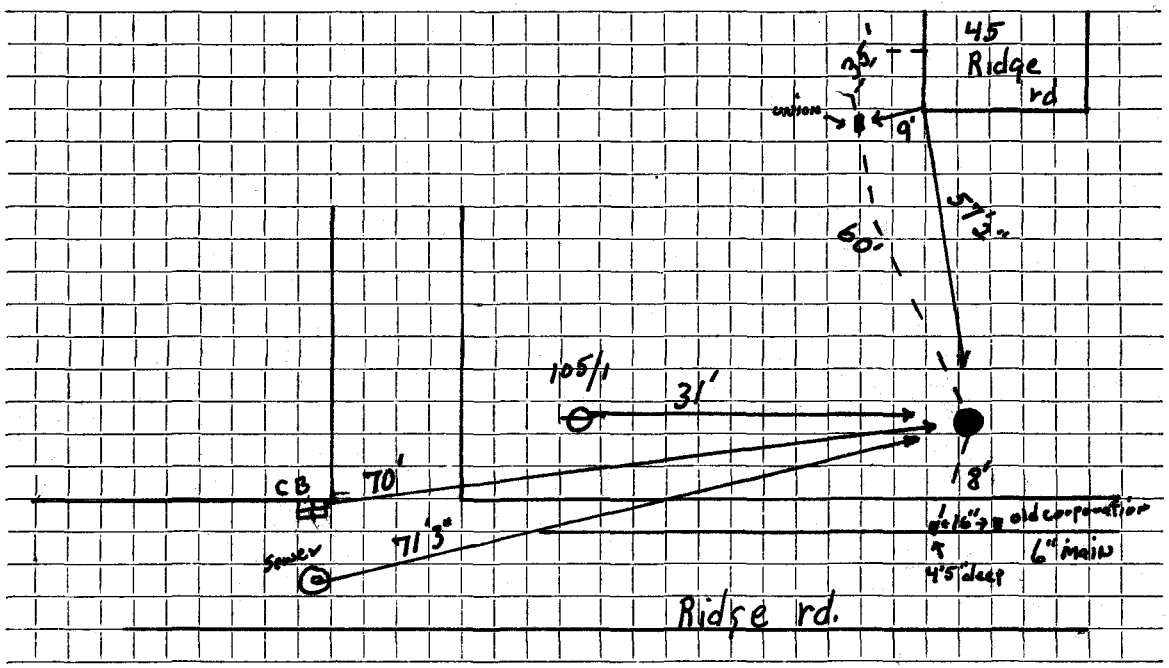

Connection made in ..... Street. Work completed .....

Remarks: .....

.....

.....