WATER SERVICE RECORD

Name *Claire McDonough* **Service No.**

Address *26 Robins Road*

Location

Repair—~~Renewal~~ ~~New Service~~ *Bruce McKee #0264*

Date		Material	Amount	Total	Date		Amount
9/29/93	31'	3/4" Copper					
	1	3/4" Comp. Union Muller					
	1	1" M x 3/4" C. Flare				OUTSIDE	
					9/29/93	3/4" Copper	
						1" Iron Size Curb	
						Box & Rod	
						Corp.	

DATE _____

TOWN OF LEXINGTON — BOARD OF PUBLIC WORKS

WATER DIVISION

Sketch of Service Here

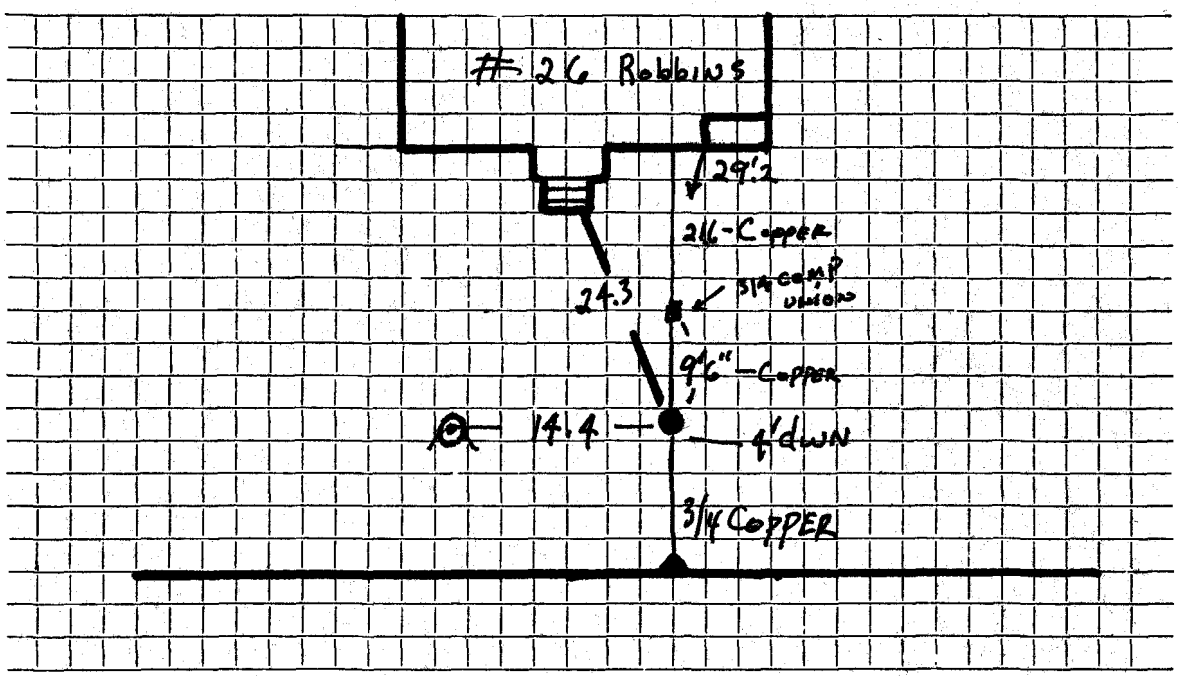

Connection made in ..... Street. Work completed .....

Remarks: GAS SERVICE IS CUT OFF IN ST. 7-29-83 - B-McKee

.....

.....