WATER SERVICE RECORD

Name

Service No.

Address 11 Rockville Ave

Location

Lot 16

Repair—Renewal—New Service

Date		Material	Amount	Total	Date			Amount
10/9/59	50'	3/4 Copper			6/25/69	17'	1" Copper	
		3/4 x 1/2 S+W3					1" Corp	Dwn 4.9
							1" Curb Stop	" 4.0
							1 x 3/4 Red.	
							buffalo box	

DATE _____

TOWN OF LEXINGTON — BOARD OF PUBLIC WORKS

WATER DIVISION

Sketch of Service Here

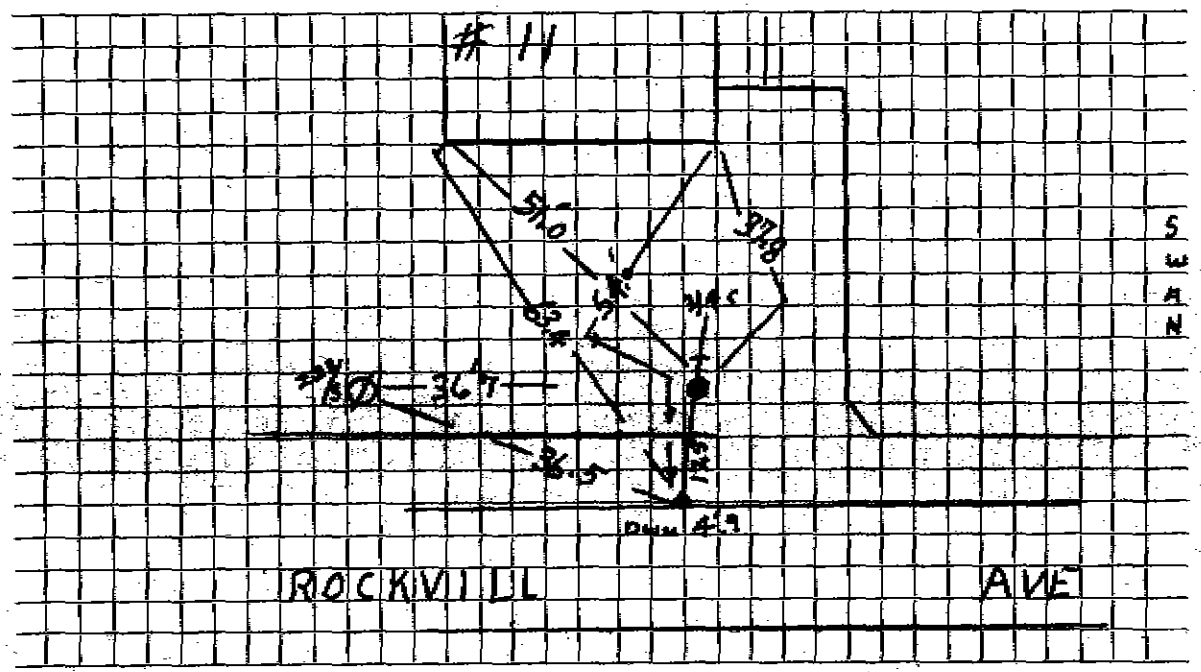

Connection made in ..... Street. Work completed 6/25/09 P.A.D. Corp.

Remarks: .....

.....

.....