WATER SERVICE RECORD

Name **Service No.**

Address 4 ROWLAND AVE

Location

Repair—Renewal—New Service

Date	Material	Amount	Total	Date	OUT	Amount
				11/22/94	CHECKED SERVICE AT CURB OK	
					3/4" COPPER	
					3/4 RED HED CURB	
					BOX + ROD	

DATE _____

TOWN OF LEXINGTON — BOARD OF PUBLIC WORKS

WATER DIVISION

Sketch of Service Here

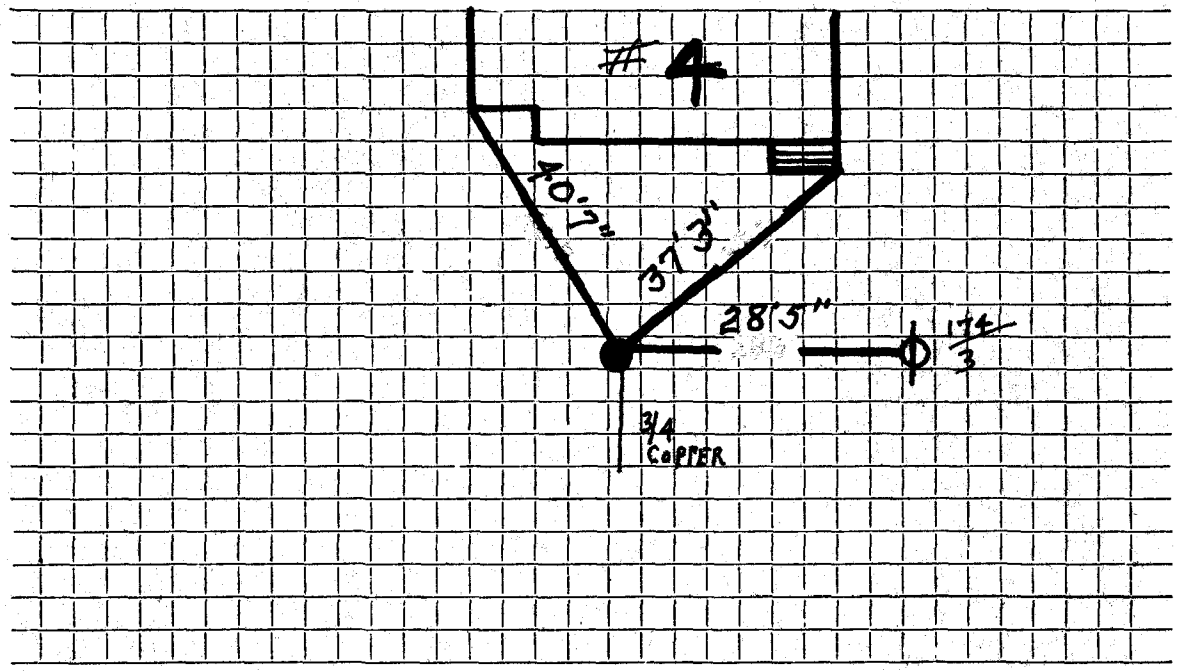

Connection made in ..... Street. Work completed .....

Remarks: .....

.....

.....