N.B.M.16010

WATER SERVICE RECORD

Name J. M. Lucente Co. **Service No.**

Address 34 Saddle Club Road

Location

Repair—Renewal—New Service J. M. Lucente Co.#501

Date		Material	Amount		Total		Date			Amount	
12/7/66	58'	3/4" Copper tubing									
							10-28-	66			
								34'	3/4" Copper		

DATE _____

TOWN OF LEXINGTON — BOARD OF PUBLIC WORKS

WATER DIVISION

Sketch of Service Here

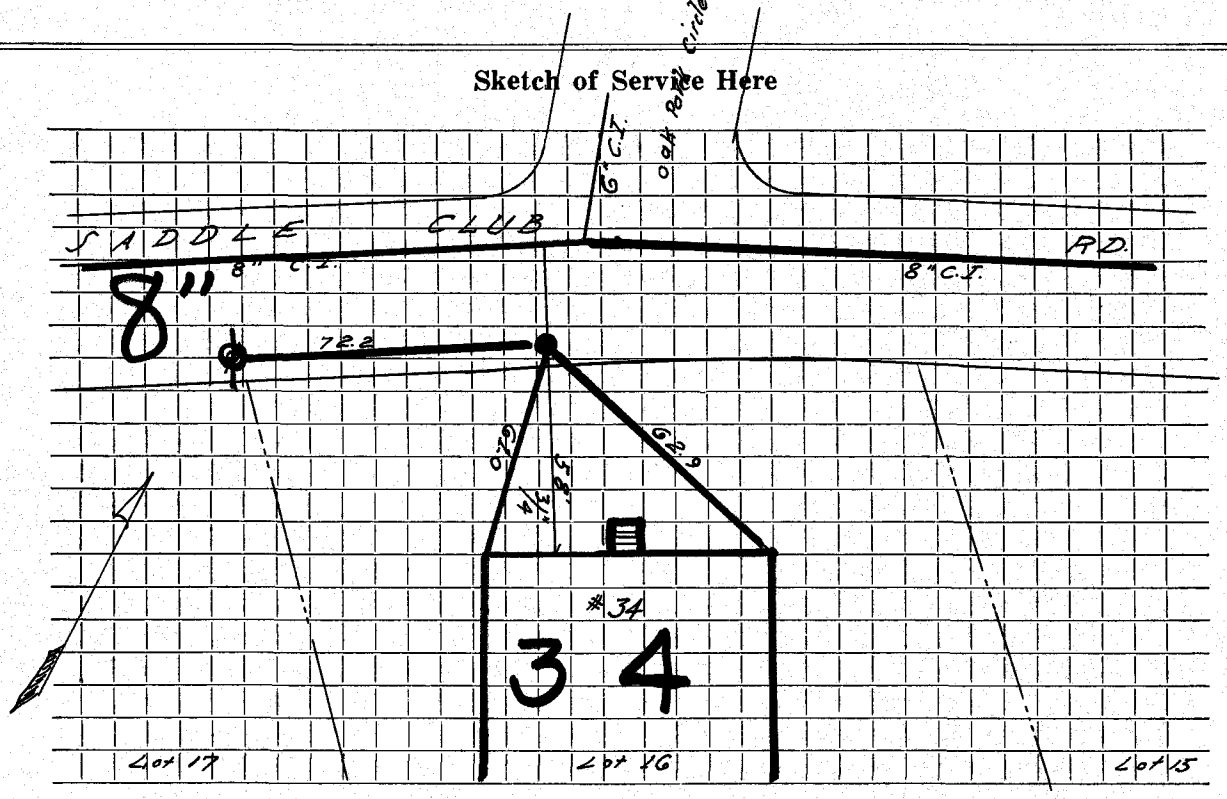

Connection made in ..... Street. Work completed .....

Remarks: .....

.....

.....