WATER SERVICE RECORD

Name Megan Shadley **Service No.**

Address 31 Sanderson Rd

Location Lexington MA Contractor: Bradley Co.

Repair—Renewal—New Service

Date		Material	Amount		Total		Date			Amount	
4-19-17		1" curb stop	1								

DATE April 2017

TOWN OF LEXINGTON — BOARD OF PUBLIC WORKS

WATER DIVISION

Sketch of Service Here

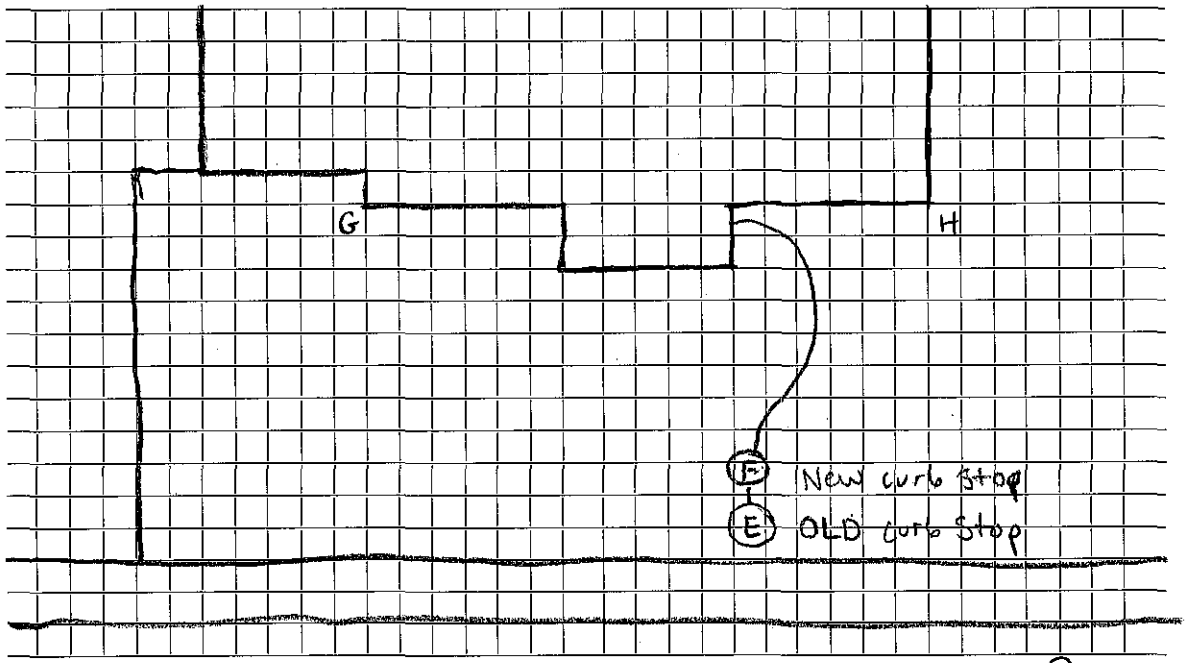

GF 54.7'
GE 56'
HF 46.4'
HE 48.8'

Connection made in 31 Sanderson Road Street. Work completed 4-19-2017

Remarks: