H.B.M.16010

WATER SERVICE RECORD

Name **Service No.**

Address 38 Sanderson Road

Location

Repair—Renewal—New Service

Date		Material	Amount		Total		Date			Amount	
5/20	76	21' - 1" copper									

DATE _____

TOWN OF LEXINGTON — BOARD OF PUBLIC WORKS

WATER DIVISION

Sketch of Service Here

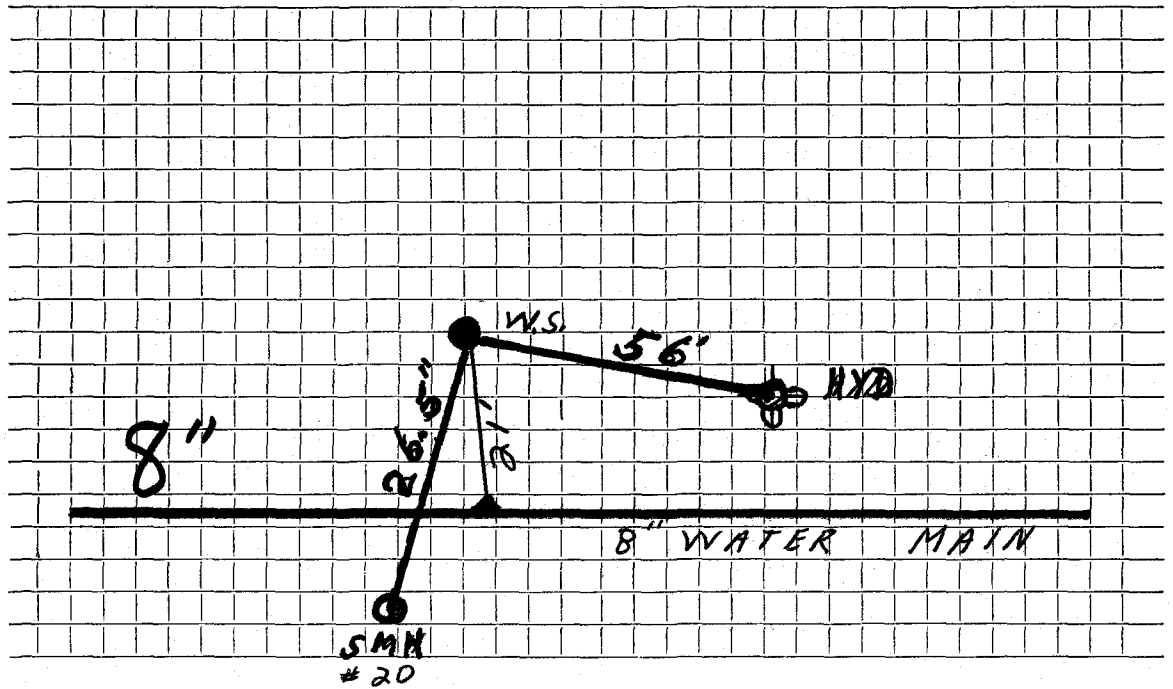

Connection made in ..... Street. Work completed .....

Remarks: .....

.....

.....