WATER SERVICE RECORD

Name Andreassi

Service No. Lot 216

Address 106 School ST

Location

Repair—Renewal—New Service

Date		Material	Amount		Total		Date			Amount	
9/10/08	11.5'	1" Copper									
		1" Corp									
		1 Curb STop									
		1"x3/4 Union									
		bufflo box									
		Existing									
6/8/55	40'	3/4 copper									
	1	3/4 x 1/2 S&W									

DATE _____

TOWN OF LEXINGTON — BOARD OF PUBLIC WORKS

WATER DIVISION

Sketch of Service Here

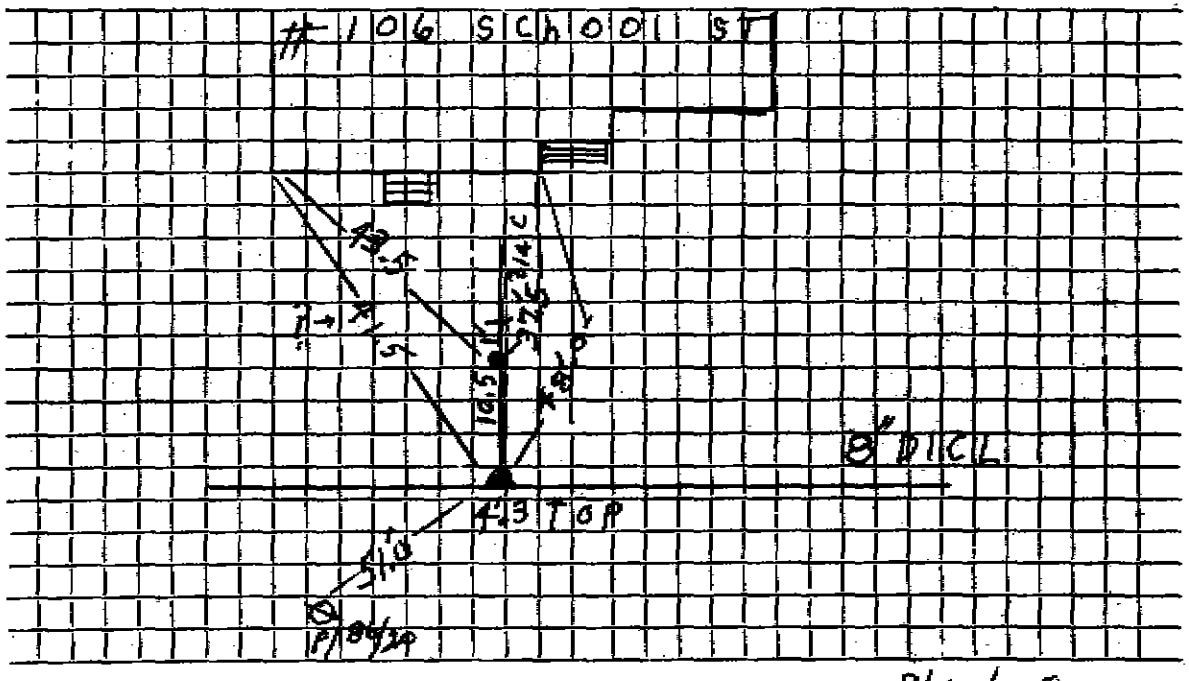

Connection made in ..... Street. Work completed 9/10/08

Remarks: .....