WATER SERVICE RECORD

Name

Service No.

Address 73 School ST

Location LoT 121

Repair—Renewal—New Service Andreassi

Date		Material	Amount	Total	Date		Amount
9/3/08	28'	1" Copper					
		1" Corp					
		1" Curb STop					
		1" Union					
		~~buff~~ lo bon					
9/28/99	46'	Existing 1" Copper					

DATE _____

TOWN OF LEXINGTON — BOARD OF PUBLIC WORKS

WATER DIVISION

Sketch of Service Here

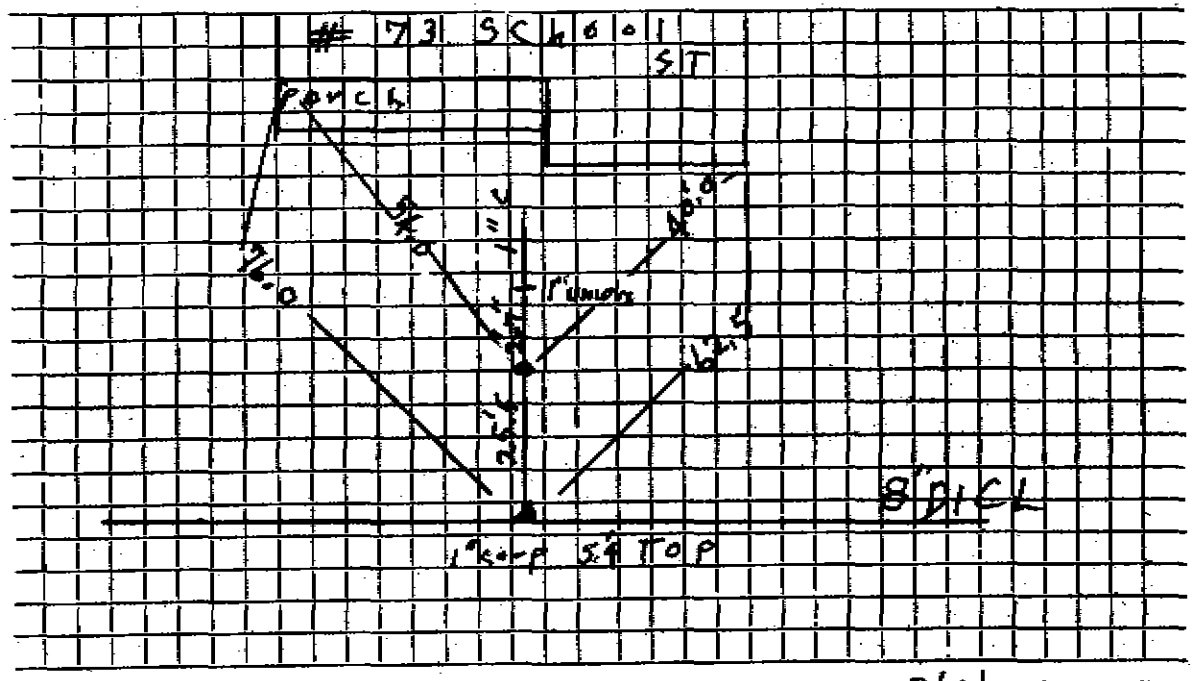

Connection made in ..... Street. Work completed 9/3/08 Andreasen

Remarks: .....