WATER SERVICE RECORD

Name

Service No.

Address 75 School ST

Location LOT 120

Repair—Renewal—New Service Andreas St

Date		Material	Amount		Total		Date			Amount	
9/3/08	25'	1" Copper									
		1" Corp									
		1" Curb STOP									
		1" x 3/4 Union									
		buffalo box									
		Existing									
7/20/50	39'	3/4 Copper									
		3/4 X 1/2 Sw									

DATE _____

TOWN OF LEXINGTON — BOARD OF PUBLIC WORKS

WATER DIVISION

Sketch of Service Here

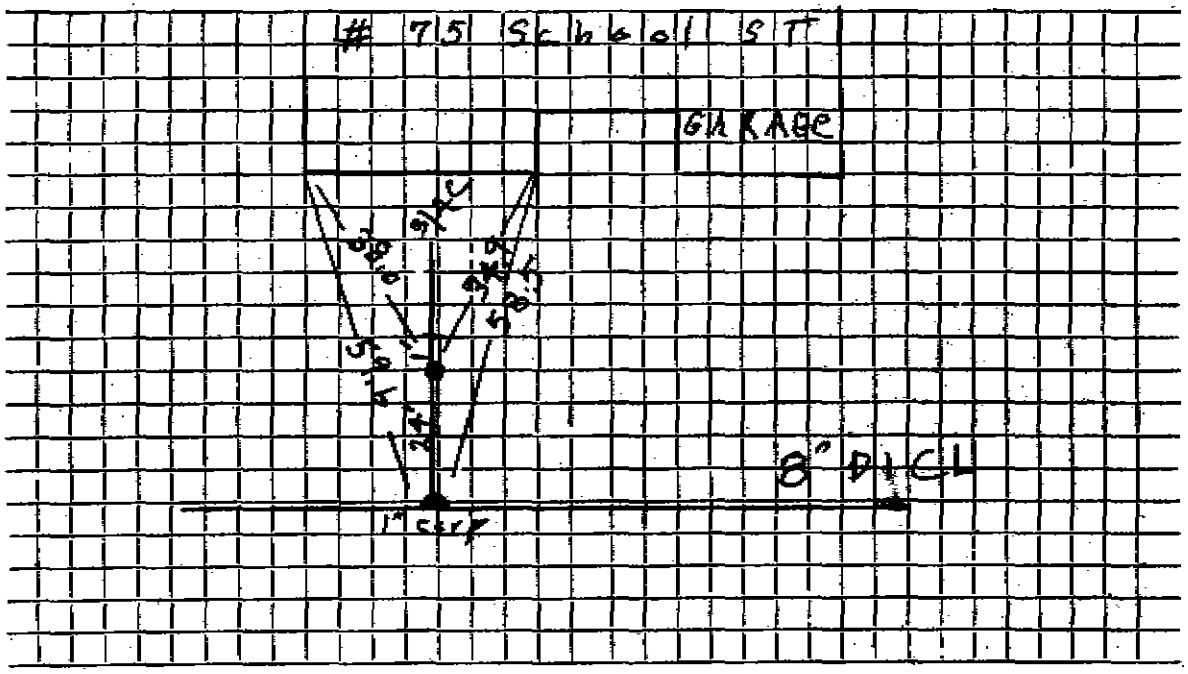

Connection made in ..... Street. Work completed 9/3/08 Andrews

Remarks: .....