WATER SERVICE RECORD

Name | **Service No.**

Address 118 Shade ST

Location LOT 45 D

Repair—Renewal—New Service Jim McLaughlin

Date		Material	Amount		Total		Date		Amount	
5/12/10	33'	1" Copper						1" Copper		
		1" Valve						1" Comp		
								1" Curb Stop		
								buffalo box		

DATE _____

TOWN OF LEXINGTON — BOARD OF PUBLIC WORKS

WATER DIVISION

Sketch of Service Here

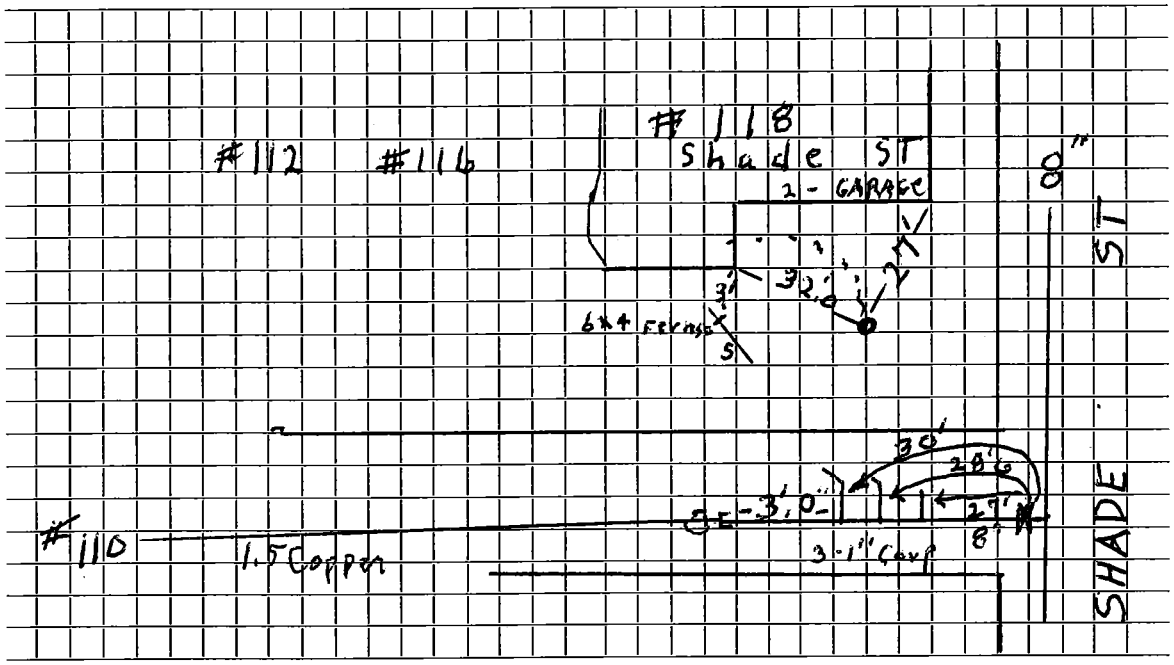

Connection made in ..... Street. Work completed .....

Remarks: 3-1" corps 1-1.5 corp

.....

.....