H.B.M.16010

WATER SERVICE RECORD

Name Bjorn Nordemo **Service No.** 22

Address # 45 Shade St.

Location

Repair—Renewal—New Service W.O.#935 Eagle #2291 Comm 10-23-73

Date		Material	Amount	Total	Date		Amount
6/18/73		labor	8 54		6-15-73	Deposit	100 00
		10% O.H.	85	9 39	6-25-73 A	Refund	50 85
		15' 3/4" copper tubing @.77		11 55			49 17
		1 3/4"curb cock		11 32			
		1 3/4"corp cock		9 57			
		1 box and rod		7 34			
6/25/73	95'	3/4" Copper tubing		49 17			
					A	Apply 41 32 to 5/8 #55	

DATE _____

TOWN OF LEXINGTON — BOARD OF PUBLIC WORKS

WATER DIVISION

Sketch of Service Here

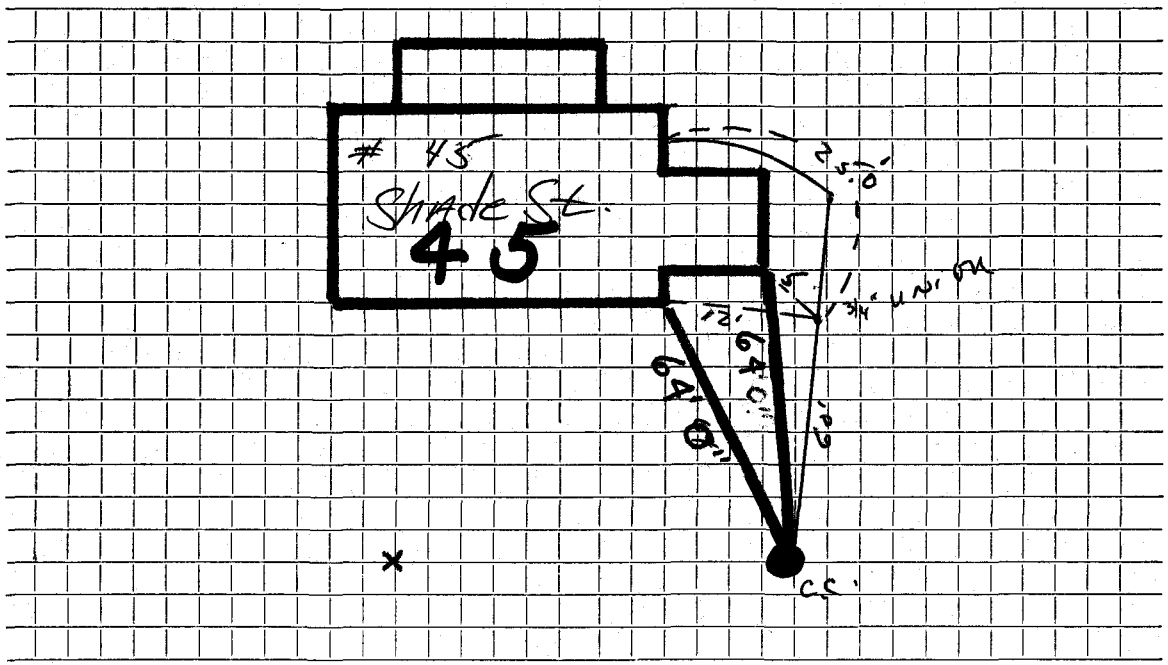

Connection made in ..... Street. Work completed .....

Remarks: Original Service 5-3-23 - Old service on old card may be dead.