WATER SERVICE RECORD

Name **Service No.**

Address 46 SHADE ST

Location

Repair—Renewal—New Service Teardown J McLaughlin

Date		Material	Amount		Total		Date		Exist	Amount	
JAN. 03	60'	1" Copper					5-5-54	28'	3/4 Copper		
	1	3/4 x 1" Increser							3/4 Corp		
	1	Buffalo box							3/4 Curb		

DATE _____

TOWN OF LEXINGTON — BOARD OF PUBLIC WORKS

WATER DIVISION

Sketch of Service Here

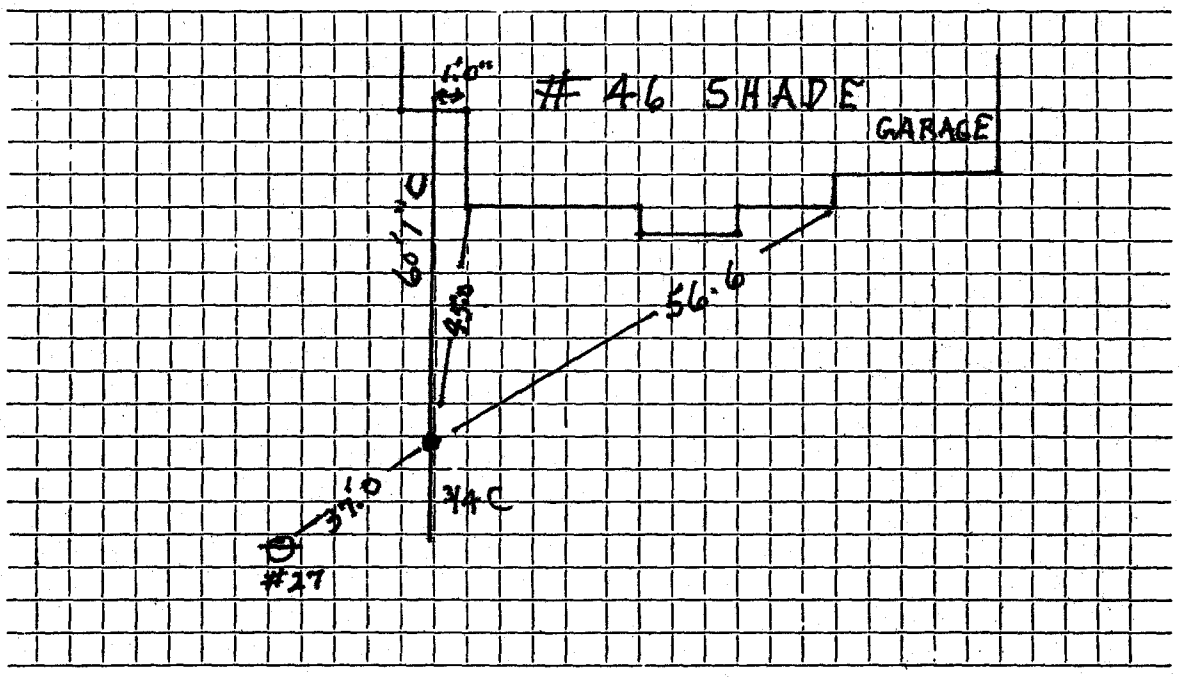

Connection made in ..... Street. Work completed .....

Remarks: .....

.....

.....