WATER SERVICE RECORD

Name | **Service No.**

Address 82 Shade Street

Location

Repair—Renewal—New Service RUGGERI CONST.

Date		Material	Amount		Total		Date			Amount	
							8/25/98	20'6"	1" COPPER		
8-31-98	166	1" copper						1	1" CORP		
	1	1" union						1	1" CURB		
								1	6" 360° CLAMP 1" TAP		
								1	Buffalo Box		

DATE _____

TOWN OF LEXINGTON — BOARD OF PUBLIC WORKS

WATER DIVISION

Sketch of Service Here

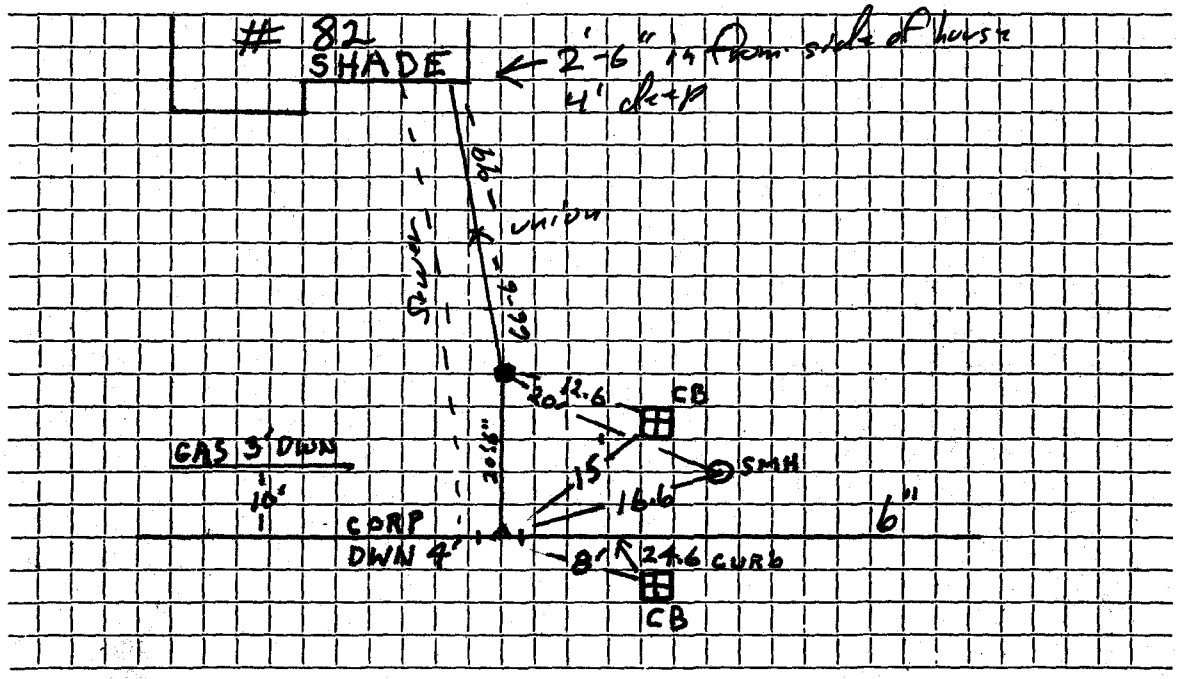

Connection made in SHADE ST. Street. Work completed .....

Remarks: 6X7-360° Clamp Tap 1"

Sewer 10' on the left