WATER SERVICE RECORD

Name | **Service No.**

Address 84 SHADE ST

Location

Repair—Renewal—New Service Ruggeri Const

Date		Material	Amount		Total		Date			Amount	
9/1/98	63.6'	1" COPPER					8/28/98				
		1" VALVE						218'	1" COPPER		
									1" CORP		
									1" Curb		
									Buffalo Box		

DATE _____

TOWN OF LEXINGTON — BOARD OF PUBLIC WORKS

WATER DIVISION

Sketch of Service Here

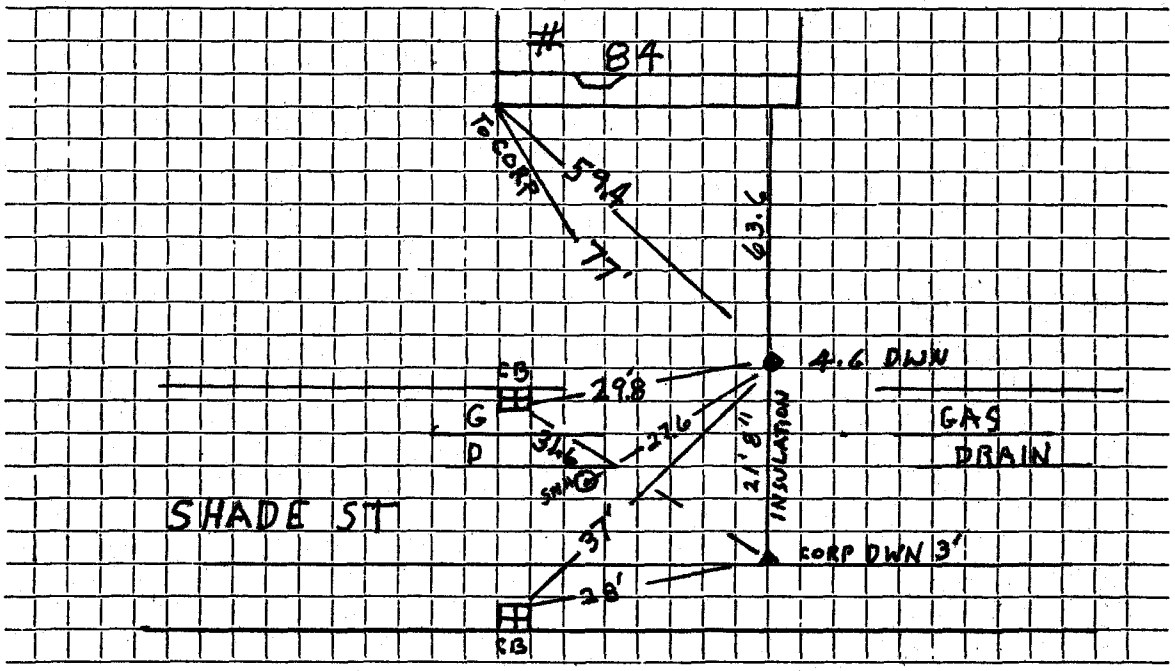

Connection made in SHADE ST. Street. Work completed .....

Remarks: INSULATION Tube + Fiberglass corp. To Curb JW DT

JW COPPER OVER DRAIN UNDER GAS