WATER SERVICE RECORD

Name **Service No.**

Address 6 Sheridan Street

Location

Repair—Renewal—New Service

Date	Material	Amount	Total	Date		Amount
					OUTSIDE	
				10/17/88	1" Copper 10/16"	
					1" Corp.	
					c/c	

DATE_____

TOWN OF LEXINGTON — BOARD OF PUBLIC WORKS

WATER DIVISION

Sketch of Service Here

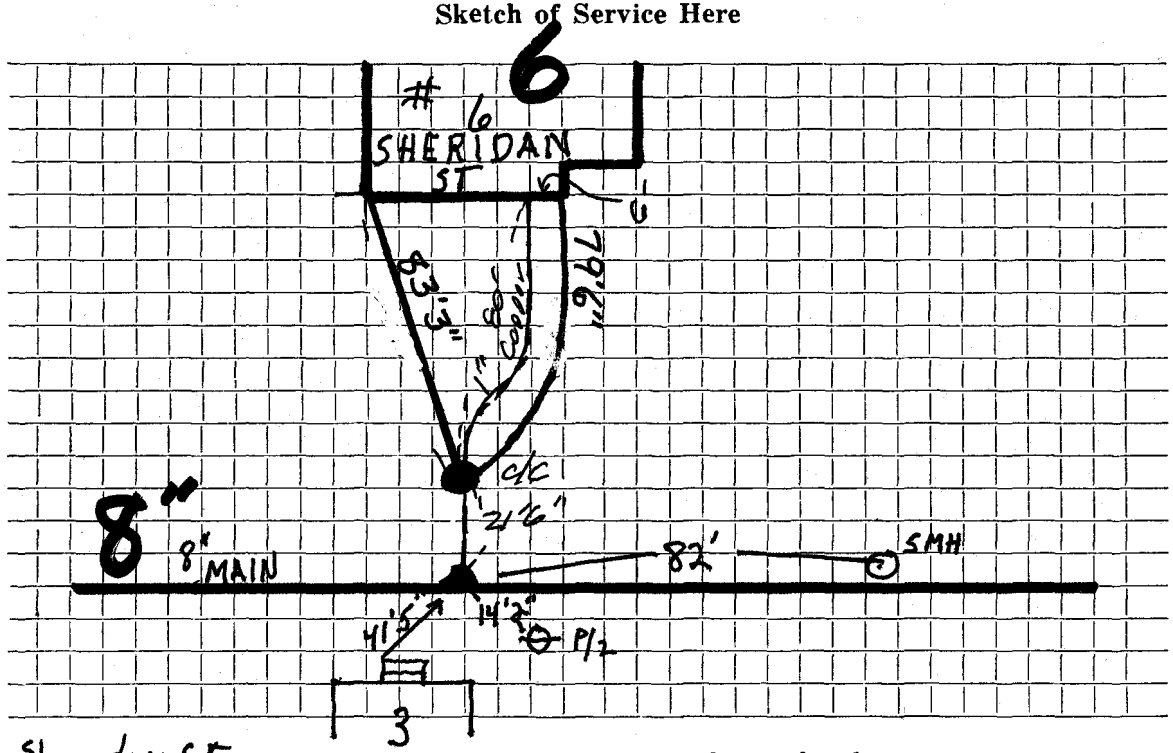

Connection made in Sheridan ST. Street. Work completed .....

Remarks: 1" Corp.