WATER SERVICE RECORD

Name **Service No.**

Address 152 SIMONDS RD.

Location

Repair—Renewal—New Service CJ Parsons #91-10

Date		OUTSIDE	Amount		Total		Date			Amount	
11-2-	92	14 LF 1" COPPER									
		1" CURB w/BOX									
		1" CURB									
		1" UNION									

DATE _____

TOWN OF LEXINGTON — BOARD OF PUBLIC WORKS

WATER DIVISION

Sketch of Service Here

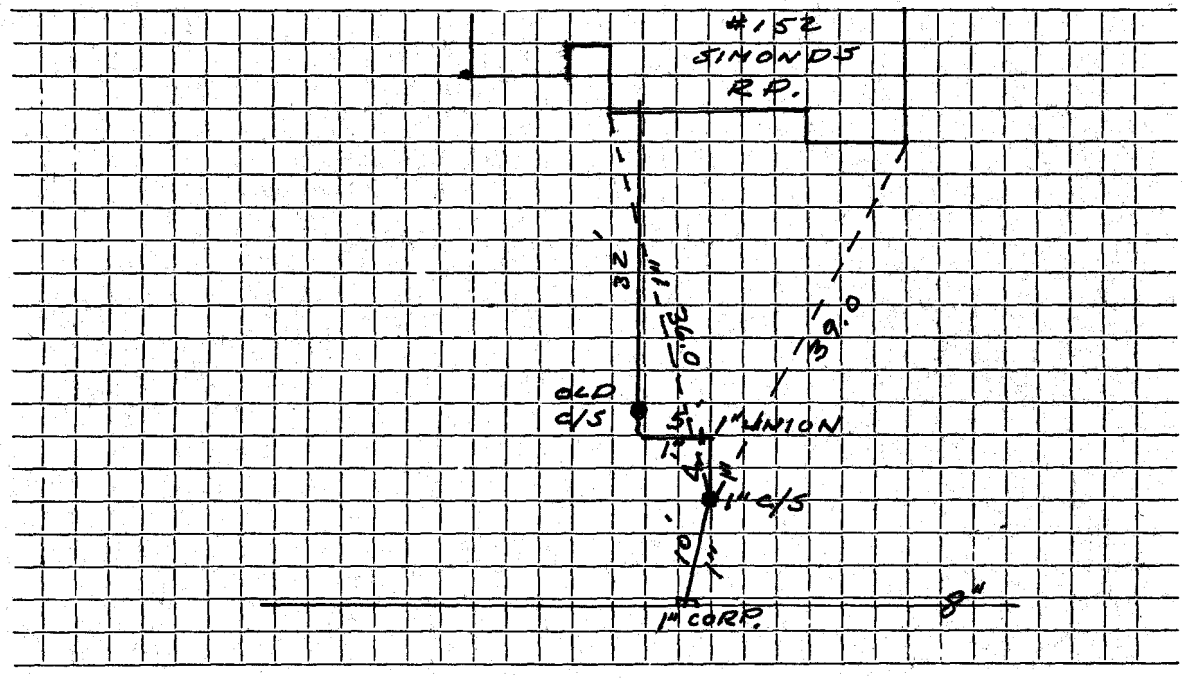

Connection made in SIMONDS RD. Street. Work completed .....

Remarks: 1" IRON INSIDE