H.B.M.16010

WATER SERVICE RECORD

2148

Name Five E's Real Estate Trust **Service No.** 24

Address 1 Skyview Road

Location Lot #3

Repair—Renewal—New Service W.O.#4692 Sibley #582

MAR 18 1968

Date		Material	Amount		Total		Date			Amount	
6-6-67	61'	3/4" Copper tubing					5-23-67		Deposit	125	00
							1-5-68		Bal	86	98
										211	98
6/1/67		Labor 69.54									
7/10/67		" 26.98	96	52							
		10% O.H.	9	65	106	17					
	27'	3/4" copper tubing @.79			21	33					
	1	3/4" corp.			7	42					
	1	curb			8	76					
	1	box & rod			5	10					
	2	ton cold patch @5.00			10	00					
	1½	ton hot top @5.80			8	70					
	5	hrs. trucking @3.00			15	00					
	3	hrs. shovel @ 6.50			19	50					
	2	hrs. compressor @5.00			10	00					
					211	98					
									Bill sent 86.98		

DATE _____

TOWN OF LEXINGTON — BOARD OF PUBLIC WORKS

WATER DIVISION

Sketch of Service Here

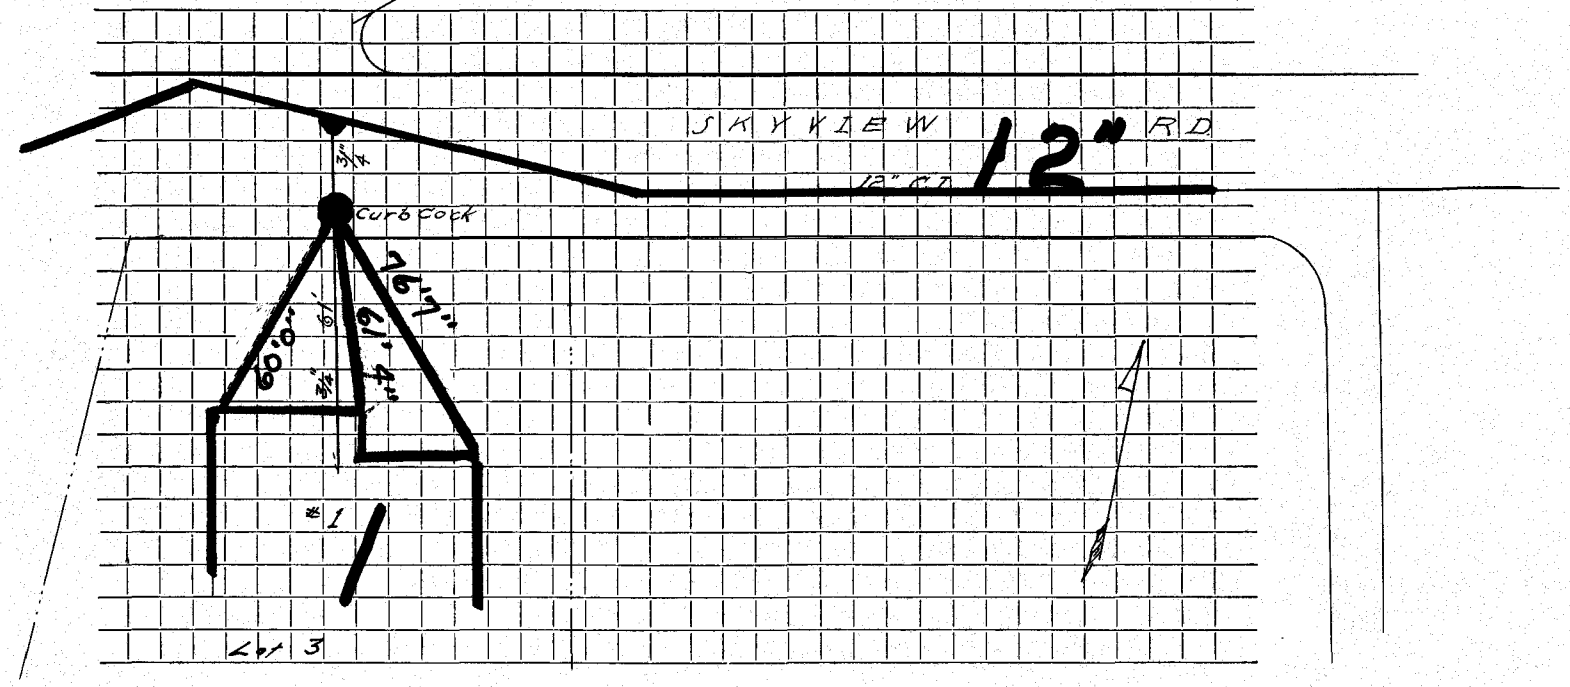

Connection made in ..... Street. Work completed .....

Remarks: .....

.....

.....