WATER SERVICE RECORD

Name LOT # ~~28~~ 27 Service No.

Address 11 SOLOMON PIERCE ROAD

Location PHEASANT BROOK ESTATES

Repair—Renewal—New Service

Date	Material	Amount	Total	Date		Amount
~~2/24~~	~~400~~ L.F. 1" TYPE K COPPER					
	~~41'~~					
2/20/86	① union					
	100' of 1" K Copper			41'	1" Copper	

DATE _____

TOWN OF LEXINGTON — BOARD OF PUBLIC WORKS

WATER DIVISION

Sketch of Service Here

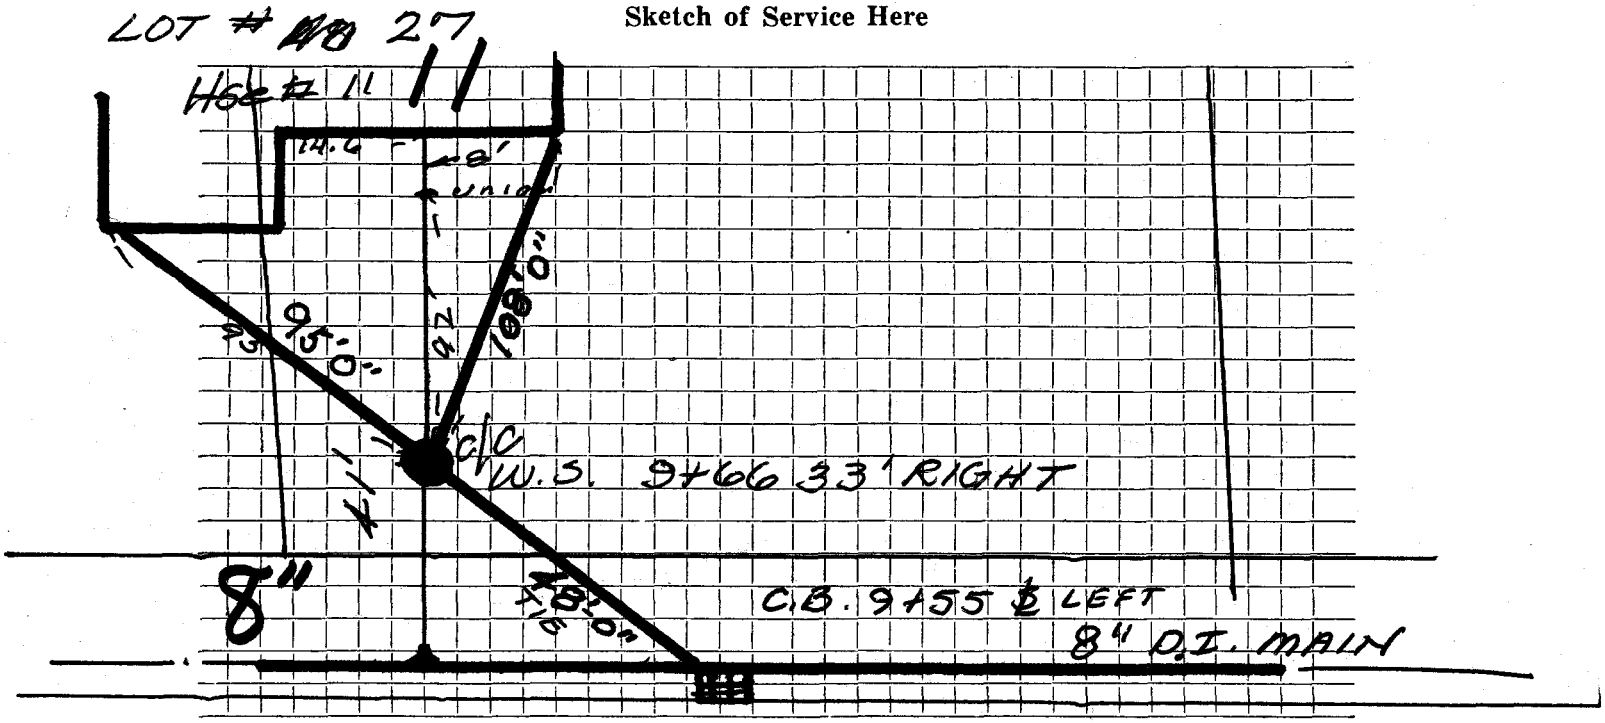

Connection made in SOLOMON PIERCE Street. Work completed .....

Remarks: .....

.....

.....