WATER SERVICE RECORD

Name **Service No.**

Address

Location 11 SOMERSET RD

Repair—Renewal—New Service ARLEX

Date		Material	Amount		Total		Date		OUT	Amount	
5/16/00	60'	1" COPPER					10/31/90	17'	1" COPPER		
	1	1" Comp UNION						1	1" CORP ADPT		
	1	Buffalo Box						1	1" Comp Curb		
	5'	EXIST 1" Copper									

DATE _____

TOWN OF LEXINGTON — BOARD OF PUBLIC WORKS

WATER DIVISION

Sketch of Service Here

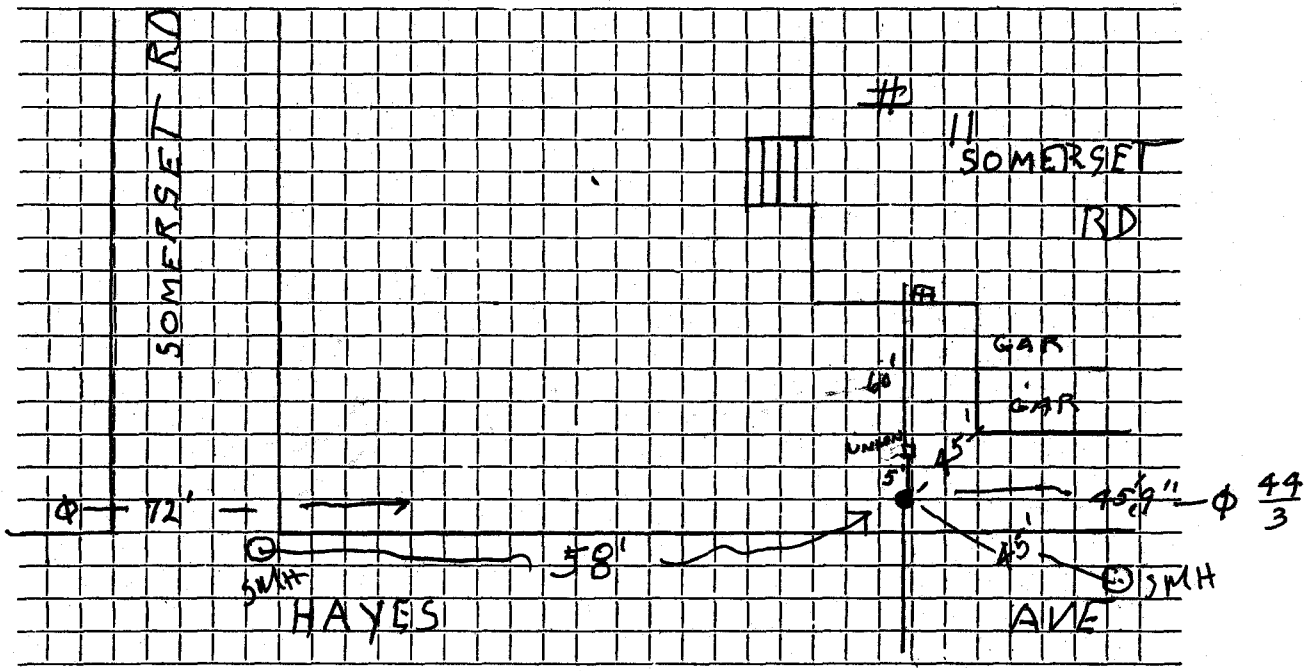

Connection made in ..... Street. Work completed .....

Remarks: GAS RUNS NEAR WATER ..... ORIGINAL SERVICE 1/4/29