HP-676

WATER SERVICE RECORD

Name J. J. Hosford **Service No.** 189 n.d.

Address 55 Spring Street

Location

~~[illegible]~~—**New Service** Com. 7-18-55

Date	Material	Amount	Total
5/21/55	Labor	1 85	
	10% overhead	19	2 04
	32' -3/4" copper tubing@.3693		11 82
	1 -3/4"Cx ½ I.W.H.stop& waste		4 00
	1 hr. trucking		75
			18 61
ORIGINAL	7/21/28		

Date		Amount
	No deposit	
8-5-55	Paid	18 61
	NON CHARGE	
5/21/55	Labor	1 85
	12' - 3/4" copper tubing@.3693	4 43
	1 - 3/4"C. adapter	1 95
	1 - 3/4"C. curb-cock	4 67
	1 box and rod	3 90
	1 -½ straight tail pc.	50
	1 -½ offset tail pc.	50
	1 hr. trucking	75
		18 55
July 02	Demi 16' 1" Copper 1" Corp 1" Curb Stop 1X3/4 Red. buffalo box	

DATE _____

TOWN OF LEXINGTON — BOARD OF PUBLIC WORKS

WATER DIVISION

Sketch of Service Here

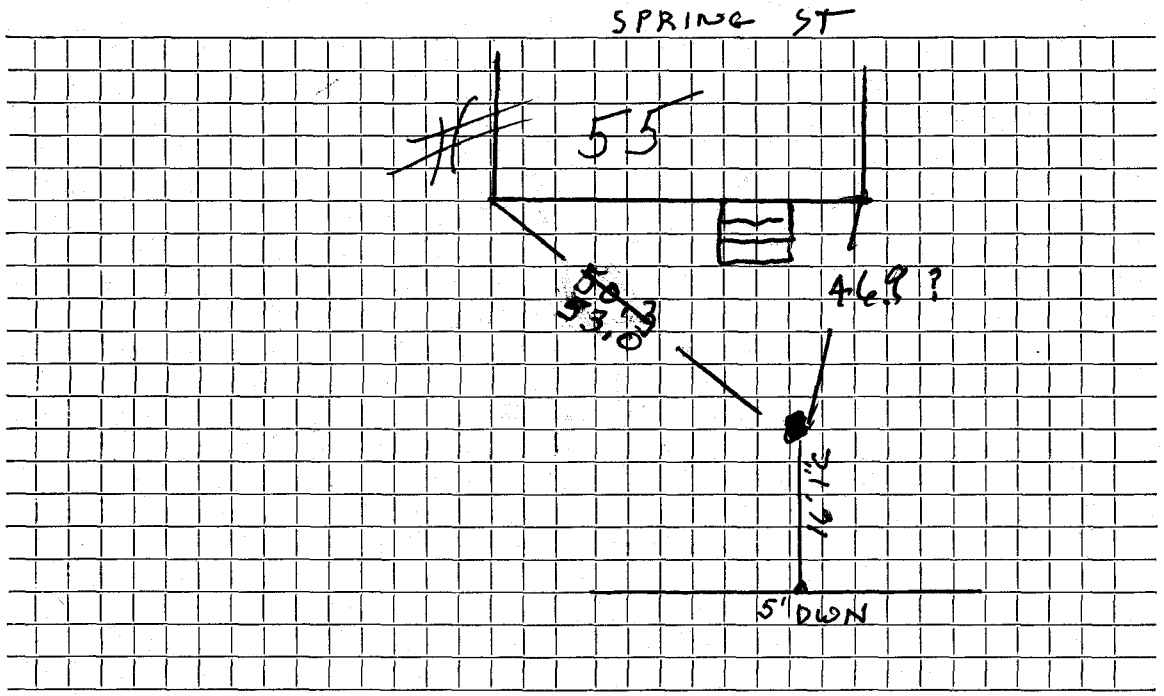

Connection made in ..... Street. Work completed 2002

Remarks: .....

.....

.....