WATER SERVICE RECORD

Name **Service No.**

Address 81 SPRING ST

Location

Repair—Renewal—New Service

Date		Material	Amount		Total		Date		Demi 2002	Amount	
June 46	88'	3/4 Copper					July 02	13'	1" Copper		
	1	3/4 Union 3 Part							1" Corp		
	1	3/4 x 3/4 S + W							1" Curb		
									1 x 3/4 Red		
									buffalo box		

DATE _____

TOWN OF LEXINGTON — BOARD OF PUBLIC WORKS

WATER DIVISION

Sketch of Service Here

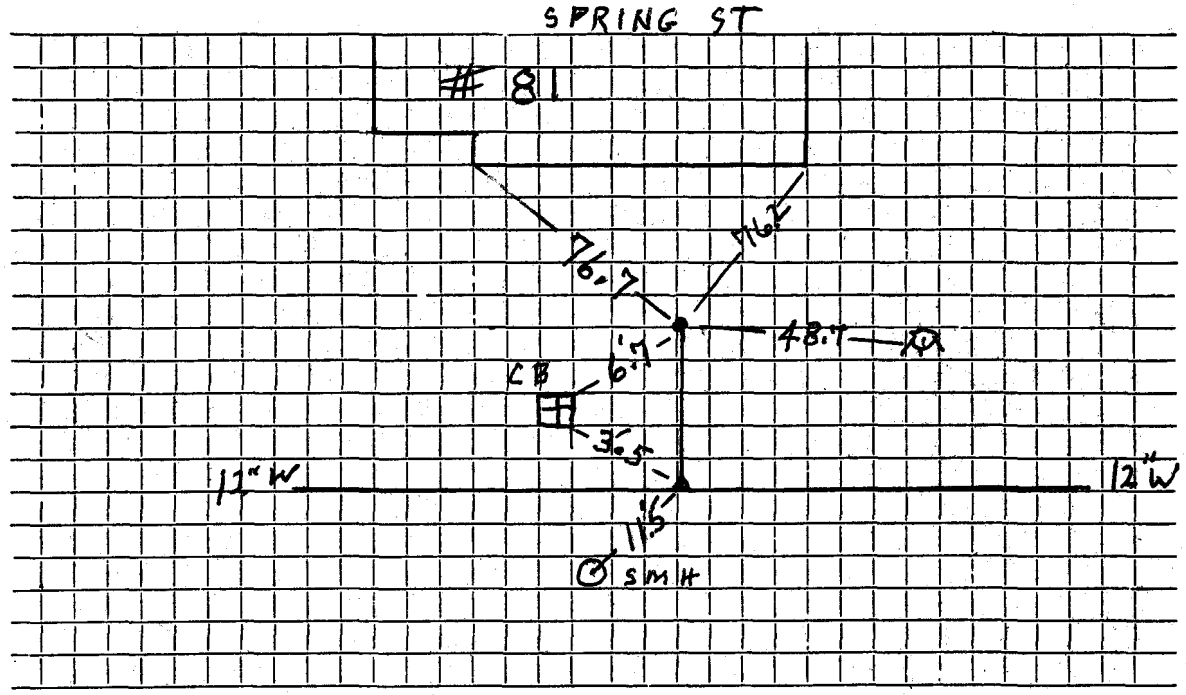

Connection made in ..... Street. Work completed 2002

Remarks: .....