WATER SERVICE RECORD

Name

Service No. 2786

Address 12 STIMSON AVE

Location

LOT 4

Repair—Renewal—New Service J. McLaughlin

Date		Material	Amount	Total	Date		Existing	Amount
5/5/08	38'	1" Copper			5/2/56	15'	3/4 Copper	
	1	3/4 x 1" Increaser					3/4 Corp	
		bufflo box					3/4 Curb Stop	

DATE _____

TOWN OF LEXINGTON — BOARD OF PUBLIC WORKS

WATER DIVISION

Sketch of Service Here

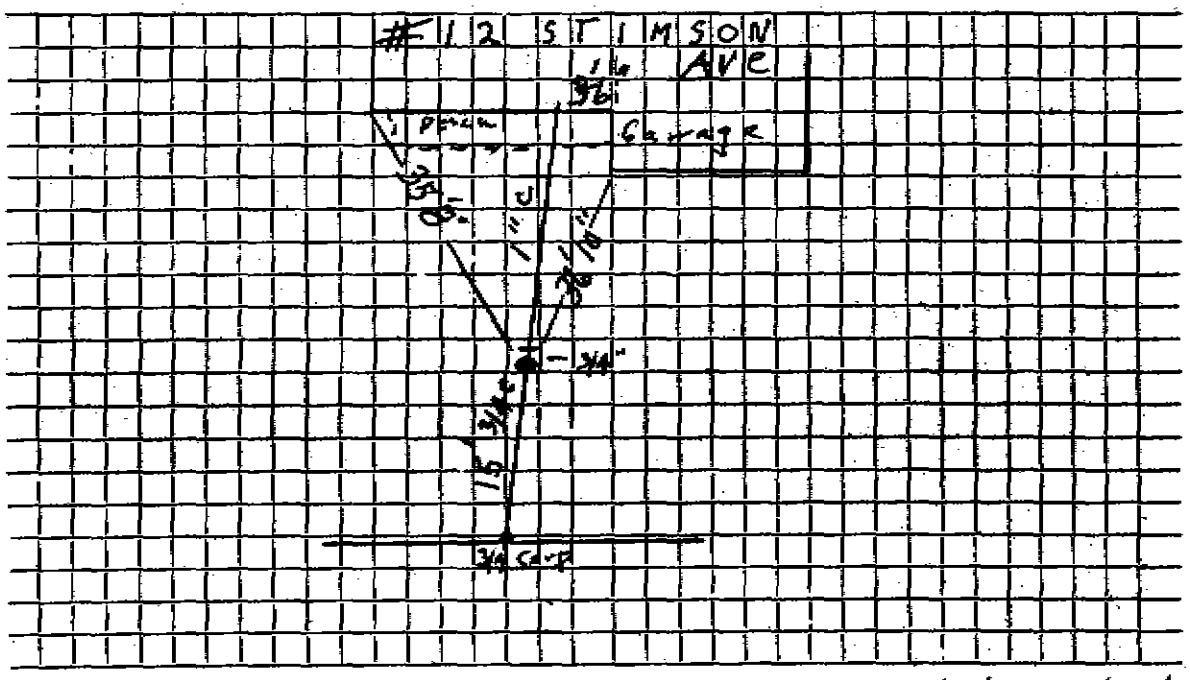

Connection made in ..... Street. Work completed 5/5/08 J. McI

Remarks: .....