WATER SERVICE RECORD

Name **Service No.**

Address 19 Stratham Rd.

Location

Repair—Renewal—New Service

Date		Material	Amount		Total		Date			Amount	
7/12	83	5' 3/4" Copper									
		3/4" Corp.									
		Curb Stop									

DATE _____

TOWN OF LEXINGTON — BOARD OF PUBLIC WORKS

WATER DIVISION

Sketch of Service Here

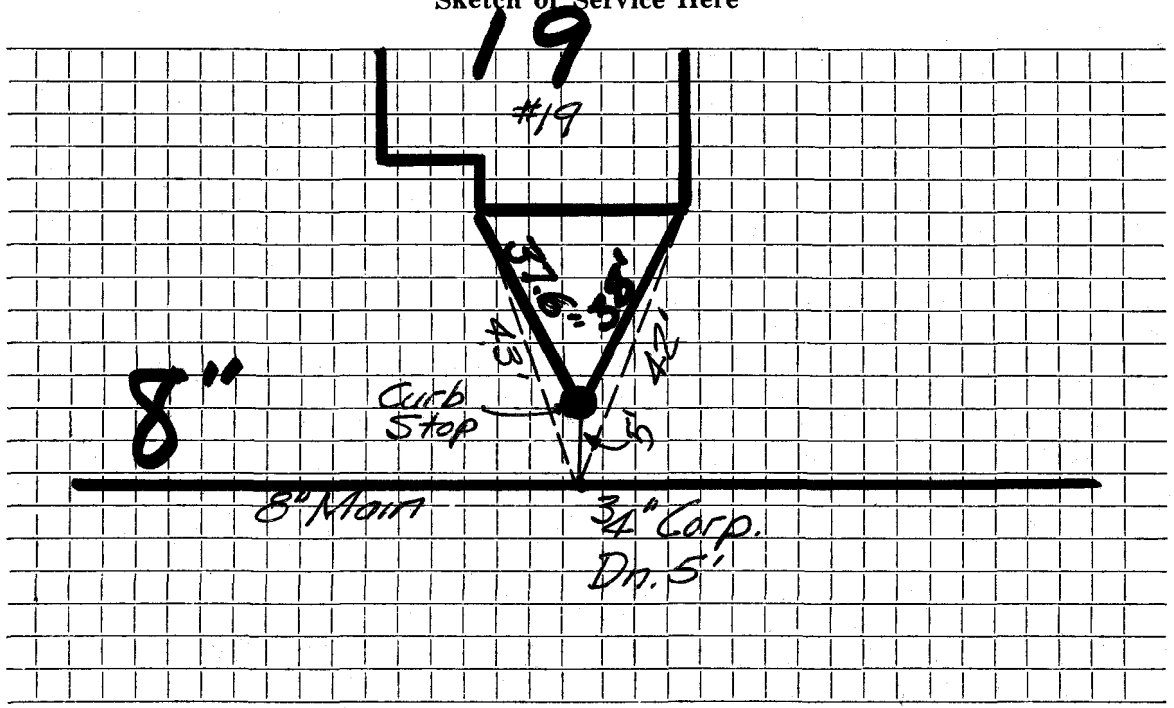

Connection made in Strathan Rd. Street. Work completed .....

Remarks: .....