WATER SERVICE RECORD

Name | **Service No.**

Address 11 SUMMER ST

Location

Repair—Renewal—New Service TAP ON LOWELL ST

Date		Material	Amount		Total		Date			Amount	
11/20/2006	140'	1" Copper					7/7/06	33'	1" Copper		
	2	1" UNIONS							1" Corp		
									1" Curb Stop		
									buffalo box		

DATE _____

TOWN OF LEXINGTON — BOARD OF PUBLIC WORKS

WATER DIVISION

Sketch of Service Here

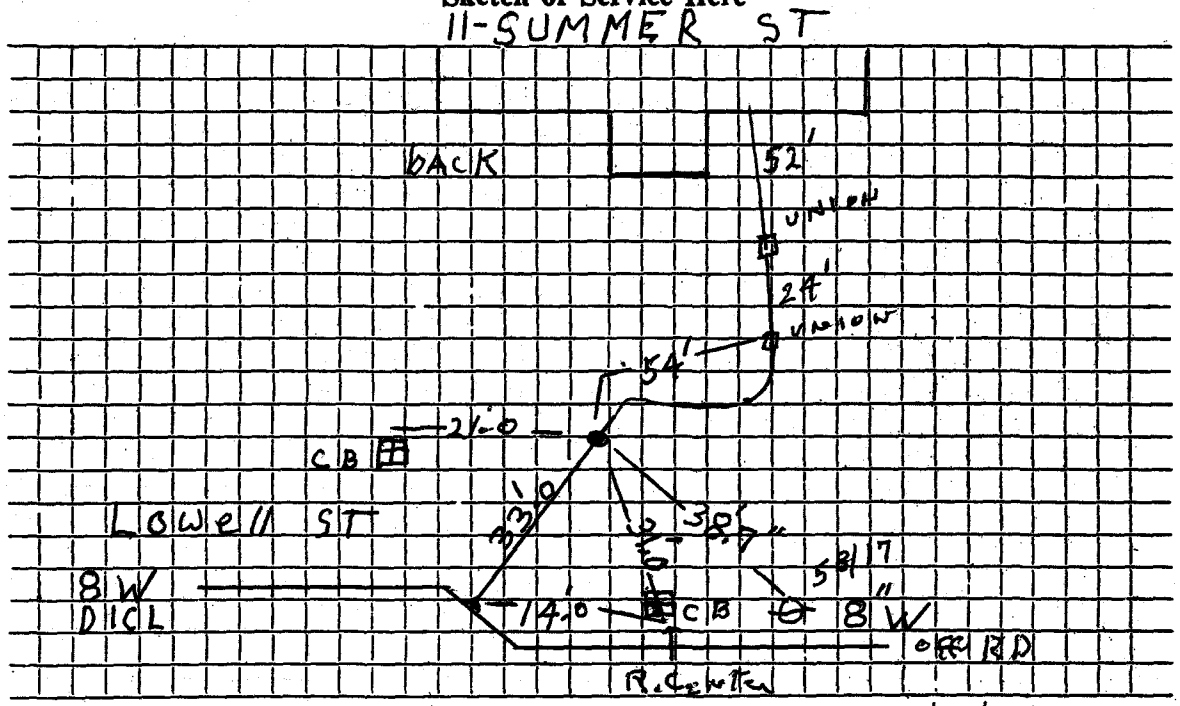

Connection made in Lowell ST Street. Work completed 7/7/06 Cedrone

Remarks: 8" Water Main behind CB.