WATER SERVICE RECORD

Name → owner Jay Patel / Cont. ?

Service No.

Address 8 Summer ST

Location Lot 36 / Pg. 28

Repair—Renewal—New Service

Date		Material	Amount		Total		Date		Existing	Amount	
10/2011	48	1" Copper					6/22/53	12'	3/4 Copper		
		1" Curb							3/4 Corp		
		1" x 3/4							3/4 Curb		
		Buffalo box							box & Rod		

DATE _____

TOWN OF LEXINGTON — BOARD OF PUBLIC WORKS

WATER DIVISION

Sketch of Service Here

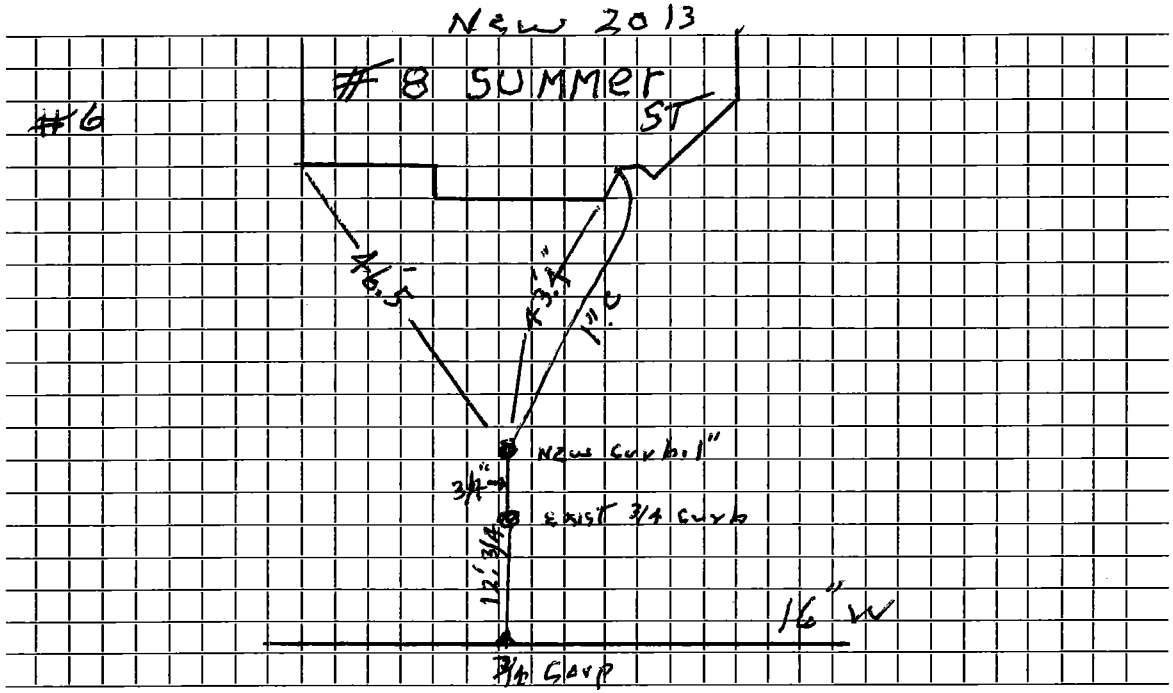

Connection made in Summer ST. Street. Work completed 10/2015

Remarks: 1" W.M.