WATER SERVICE RECORD

Name

Service No.

Address 34 Summit Rd

Location Lot 114

Repair—Renewal—New Service

Date		Material	Amount		Total		Date		PAO Corp	Amount	
6/22/54	42'	3/4 Copper					6/22/01	9.5	1" Copper		
		3/4 x 1/2 S+W							1" Corp		
									1" Curb Stop		
									1" x 3/4 Redu.		
									buffalo box		

DATE _____

TOWN OF LEXINGTON — BOARD OF PUBLIC WORKS

WATER DIVISION

Sketch of Service Here

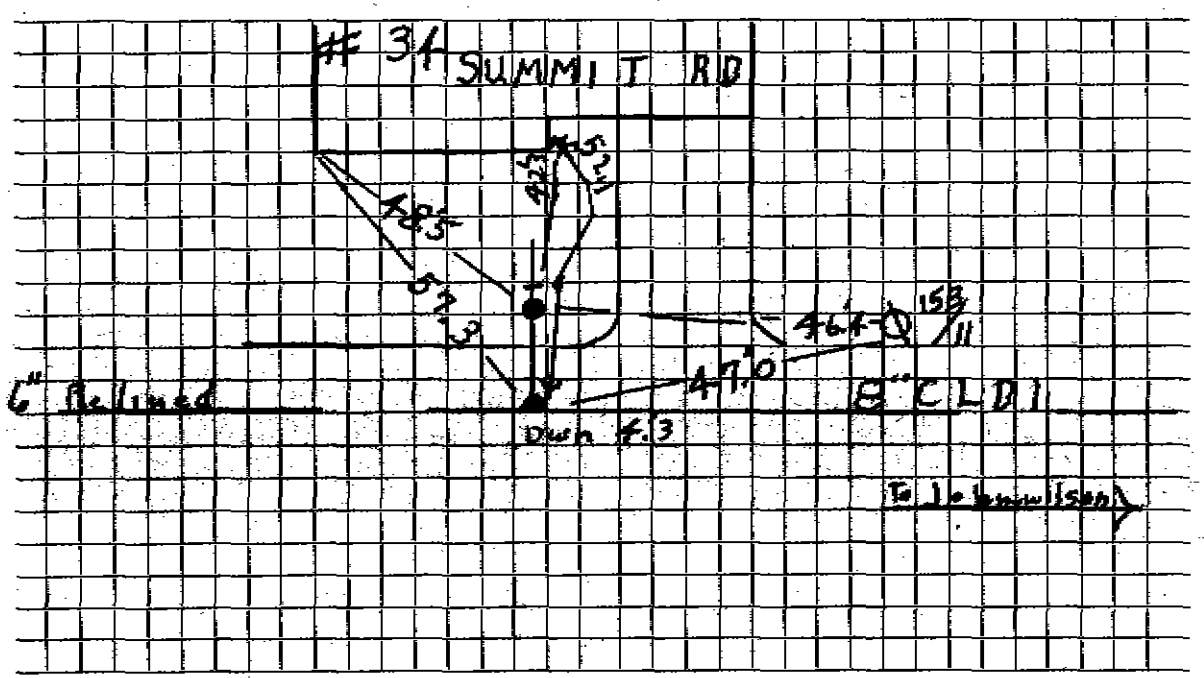


Remarks: 8" Tie's in to John Wilson