WATER SERVICE RECORD

Name | **Service No.**

Address 29 Tarbell

Location

Repair—Renewal—New Service

Date	Material	Amount	Total	Date		Amount
				8·17·62	28' 3/4 C.T.	
3·31·99	51.5 - 1" Copper				1 3/4 curb	
	1 - 3/4"x1" Comp. Curb				1 3/4 Corp	

DATE _____

TOWN OF LEXINGTON — BOARD OF PUBLIC WORKS

WATER DIVISION

Sketch of Service Here

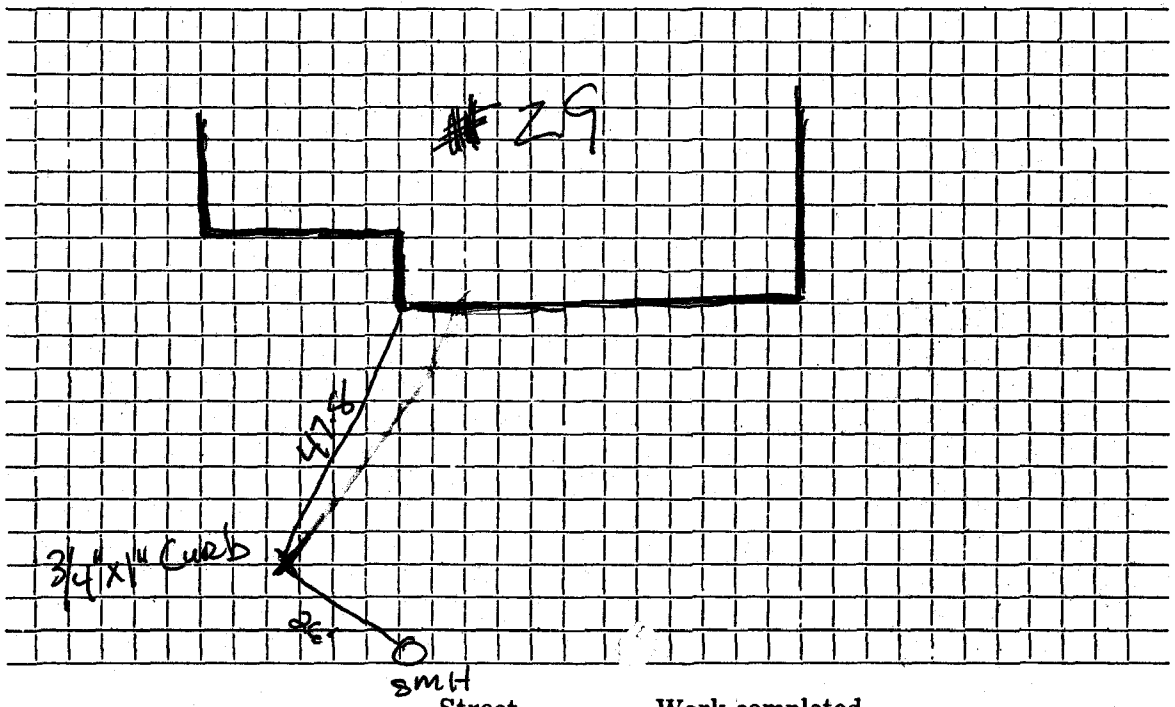

Connection made in ..... Street. Work completed .....

Remarks: .....

3-31-99 New service put in to house - curb was replaced also