H.B.M.16010

#394

WATER SERVICE RECORD

Name Mark Moore **Service No.** 10

Address 12 Taven Lane

Location

[redacted]—**New Service** W.O.#4237 DeFlice #555

JAN 22 1968

Date		Material	Amount		Total		Date			Amount	
4-13-67	52'	3/4" Copper tubing					3-30-67		Deposit	50	00
							1-22-68	#	Refund	5	57
4/5/67		Labor	6	68						44	43
		10% O.H.		67	7	35					
	20'	3/4" copper tubing @.79			15	80					
	1	3/4" Corp.			7	42					
	1	3/4" Curb Cock			8	76					
	1	Box & Rod			5	10					
					44	43					
								#	Applied to WHC#9		

DATE _____

TOWN OF LEXINGTON — BOARD OF PUBLIC WORKS

WATER DIVISION

Sketch of Service Here

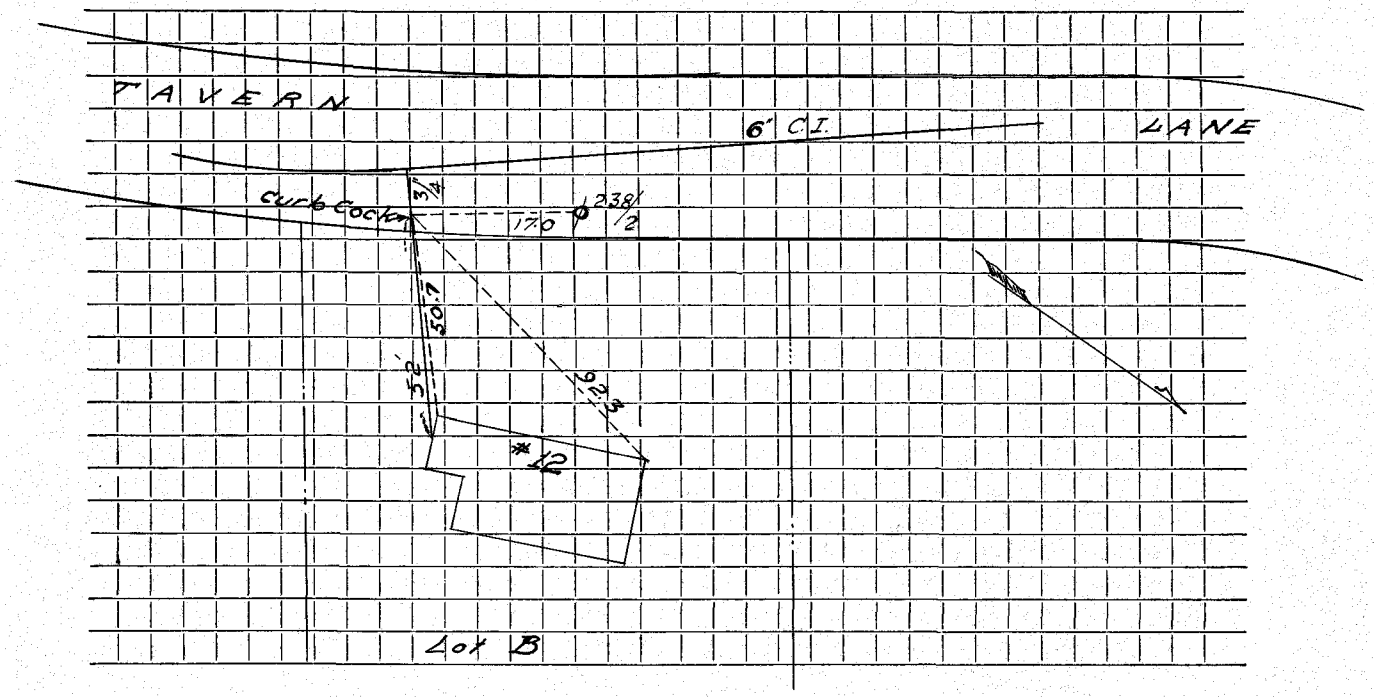

Connection made in ..... Street. Work completed .....

Remarks: .....

.....

.....