WATER SERVICE RECORD

Name **Service No.**

Address #8 Tidd Circle

Location Lot 9

Repair—Renewal—New Service

Date	Material	Amount	Total	Date		Amount
~~1984~~	~~27' of 1" Copper~~		~~N.C.~~			
				'84'		
				27'	1" Copper	

DATE_____

TOWN OF LEXINGTON — BOARD OF PUBLIC WORKS

WATER DIVISION

Sketch of Service Here

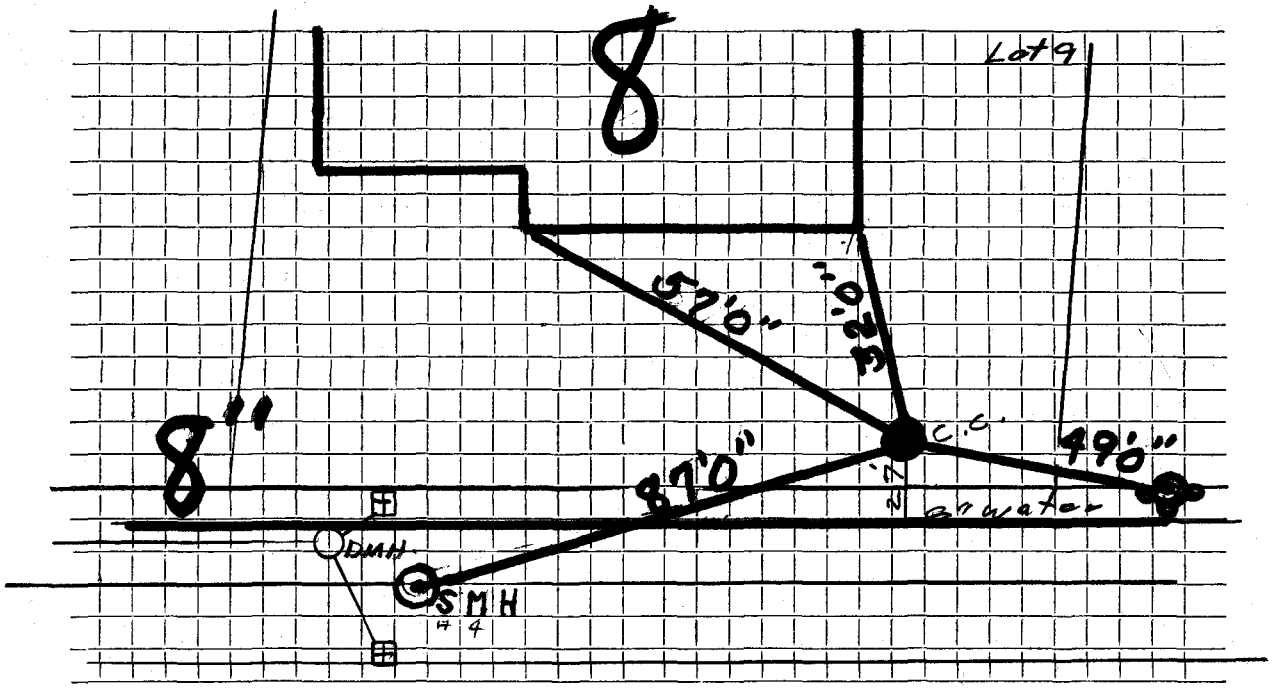

Connection made in ..... Street. Work completed .....

Remarks: .....

.....

.....