H.B.M.16010

#6429

WATER SERVICE RECORD

Name VonCormier Real Estate Dev. Corp. **Service No.** 102

Address 8 Todd Road

Location Lot #24 Sta. 6+42 El. 180.74

Repair—Renewal—New Service WO # 7510 Comm 10-29-62

Date		Material	Amount	Total	Date			Amount
6-23-62		Labor	2.13		8-8-62		Deposit	50.00
		10% O.H.	.21	2.34	10-29-62		Paid by SH C# 121	7.99
	19'	3/4" Copper tubing @.42		7.98				
	1	hr. Trucking @3.00		3.00				
		BILL WHEN CONNECTED		13.32			NON CHARGE	
8-21-62		Labor	4.22		6-23-62		Labor	2.13
		10% O.H.	.42	4.64		11'	3/4" Copper tubing @.42	4.62
	70'	3/4" Copper tubing @42		29.40		1	3/4" C Corp Cock	4.91
	1	3/4" CX½ I.W.H. Stop& Waste		6.17		1	3/4" C Curb Cock	6.28
	2	3/4" C3 Part Union @2.41		4.82		1	Box & Rod	4.90
				58.35				22.84
					8-21-62	1	½ Straight Tailpiece	.50
						1	½ Offset Tailpiece	.50
								23.84
							Bill sent 36	

DATE _____

TOWN OF LEXINGTON — BOARD OF PUBLIC WORKS

WATER DIVISION

Sketch of Service Here

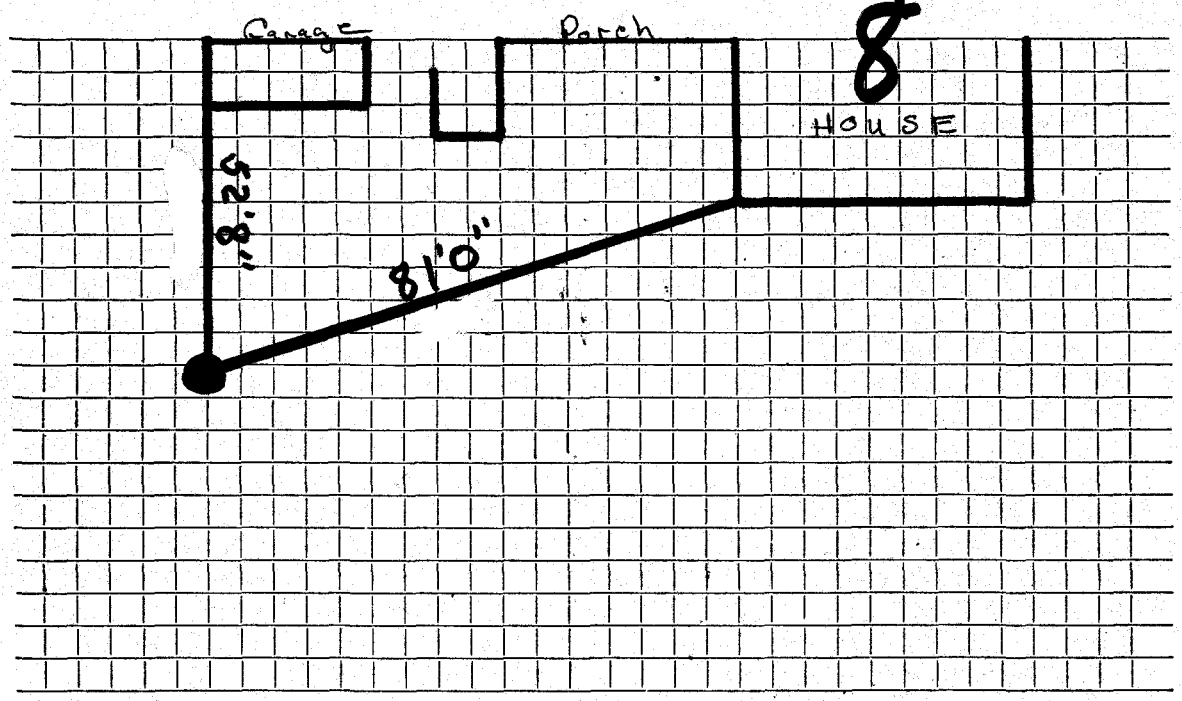

Connection made in ..... Street. Work completed .....

Remarks: .....

.....

.....