K.B.M.16010

WATER SERVICE RECORD

Name MacL & B. Realty Trust **Service No.** 50

Address 34 Tower Road

Location 34 Tower Road

~~Repair Renewal~~ New Service DeFlice Bros. #1752 W.O. # 9077

DEC 31 1970

Date		Material	Amount		Total		Date			Amount	
11/4/70		Labor			14	04	10-14-70		Deposit	75	00
		10% O.H.			1	40	1-18-71	*	Refund	19	51
	14'	Copper pipe .79			11	06				55	49
		3/4" Corporation			9	57					
		3/4" Curb Stop			11	32					
		Box & Rod			5	10					
	1	Hr. Trucking			3	00					
					55	49					
11-10-70	37'	3/4" Copper tubing									
								*	Apply 4.49 to SHEET 103		

DATE _____

TOWN OF LEXINGTON — BOARD OF PUBLIC WORKS

WATER DIVISION

Sketch of Service Here

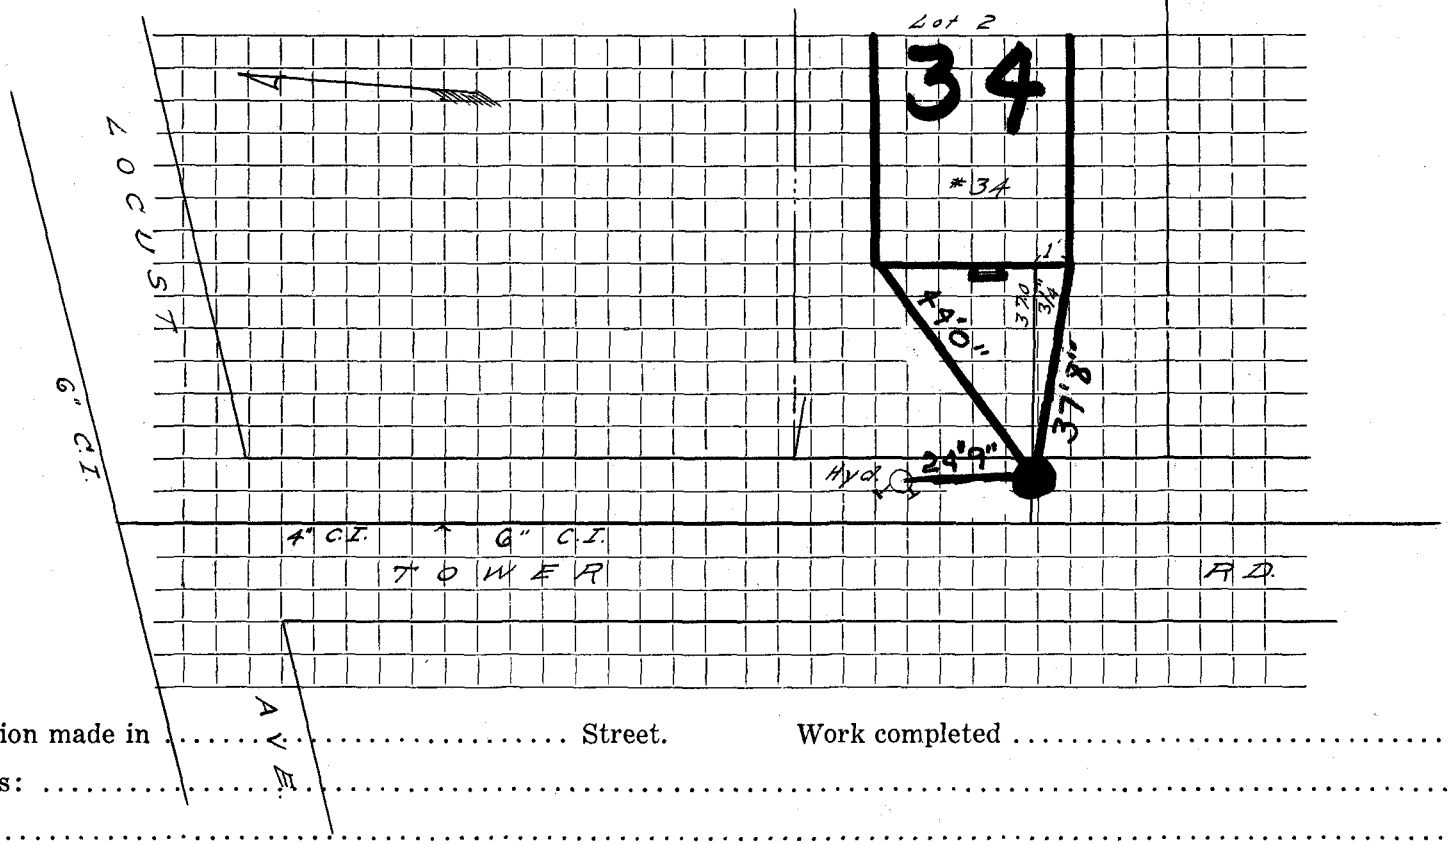

Connection made in ..... Street. Work completed .....

Remarks: .....

.....

.....