H.B.M.16010

#6707

WATER SERVICE RECORD

Name Louis Stoico **Service No.**

Address 11 Tricorne Road

Location Lote#5

Repair—Renewal—New Service Eagle #946

Date		Material	Amount		Total		Date			Amount	
10-19-67	43'	3/4" Copper tubing									

DATE _____

TOWN OF LEXINGTON — BOARD OF PUBLIC WORKS

WATER DIVISION

Sketch of Service Here

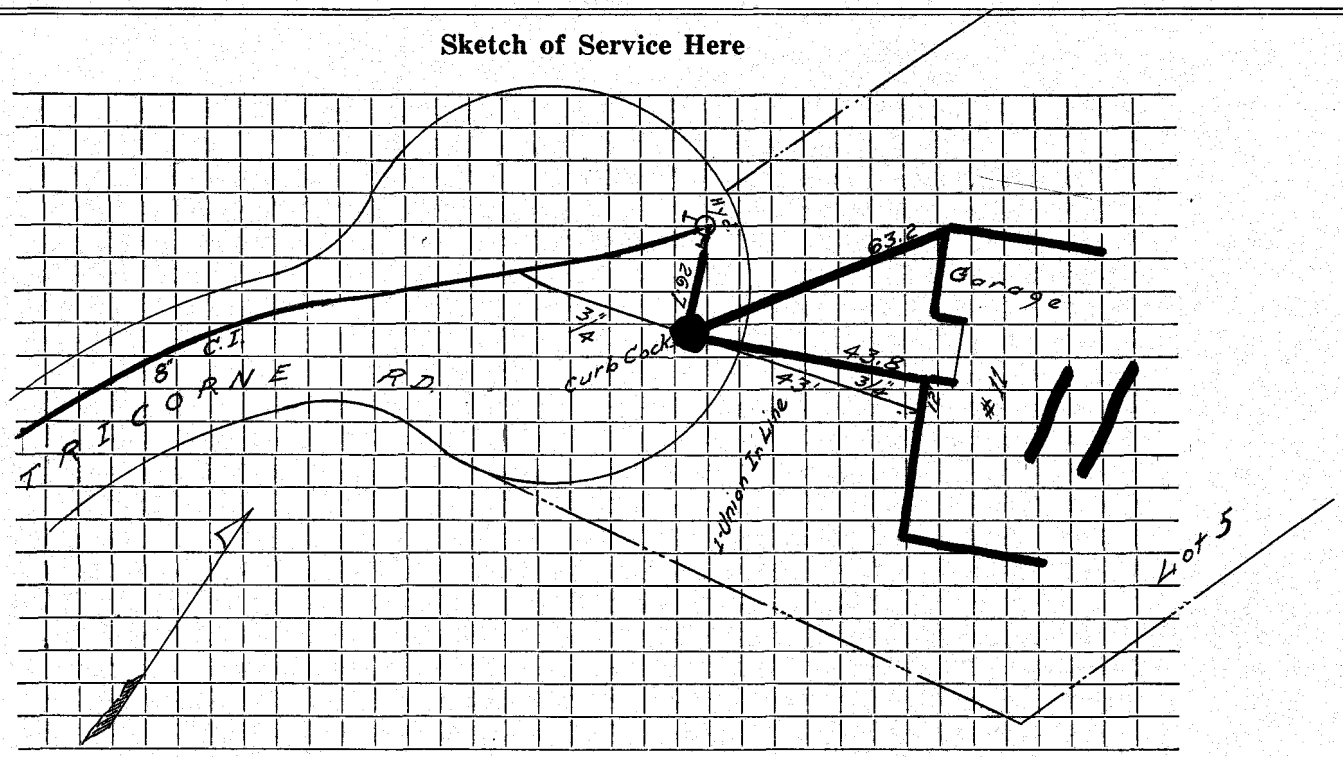

Connection made in ..... Street. Work completed .....

Remarks: .....

.....

.....