WATER SERVICE RECORD

Name | **Service No.**

Address 19 UTICA ST

Location LOT 62A

Repair—Renewal—New Service

Date		Material	Amount		Total		Date		Deflice	Amount	
8/7/51		3/4" Copper			0		9/13/07	31.6'	1" Copper		
		3/4 x 1/2 Stw						1	1" Corp		
								1	1" Curb STop		
								1	1" x 3/4" Red.		
									bufflo box		

DATE _____

TOWN OF LEXINGTON — BOARD OF PUBLIC WORKS

WATER DIVISION

Sketch of Service Here

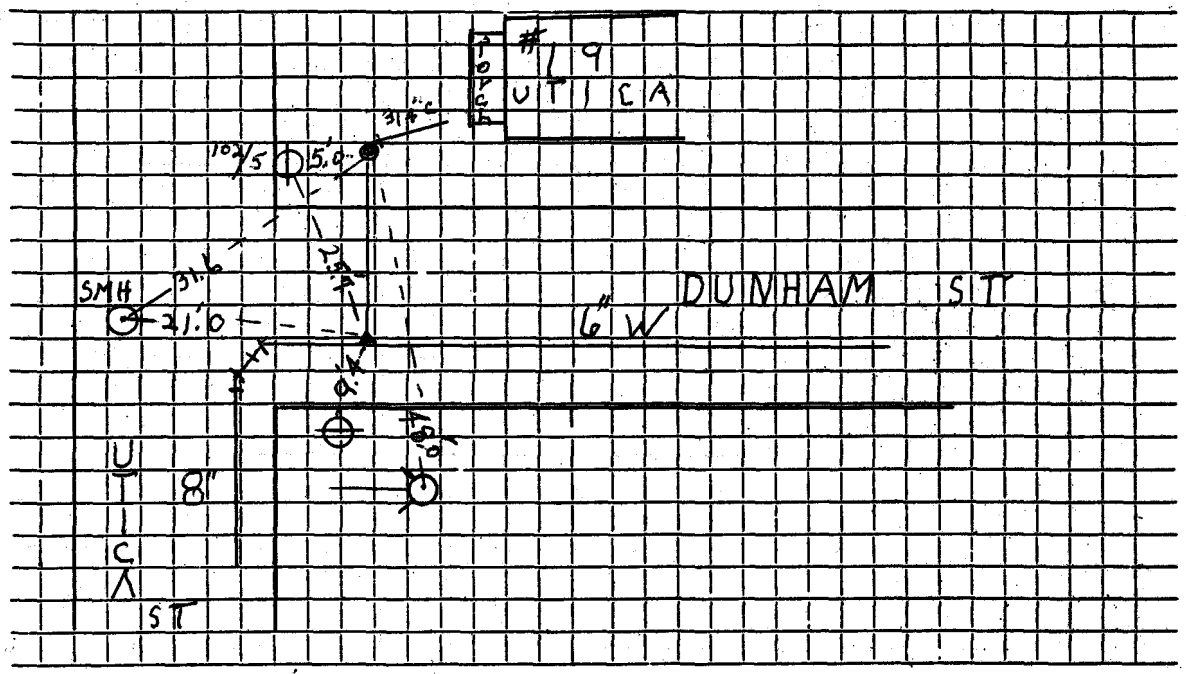

Connection made in Dunham ST 31.6-1" Copper Street. Work completed Sept 13/07 Deflice

Remarks: 2007 8" DICL