H.B.M.16010

WATER SERVICE RECORD

Name Pond Realty Trust **Service No.** 3483

Address 39 Vaille Avenue

Location Lot #32

Repair—Renewal—New Service Wm. Burns Permit #176
~~DeFlice Bros~~ ~~#A43~~

Date		Material	Amount		Total		Date			Amount	
Dec 64	18'	3/4" Copper tubing									
11-15-65	34.5'	3/4" Copper tubing									

DATE _____

TOWN OF LEXINGTON — BOARD OF PUBLIC WORKS

WATER DIVISION

Sketch of Service Here

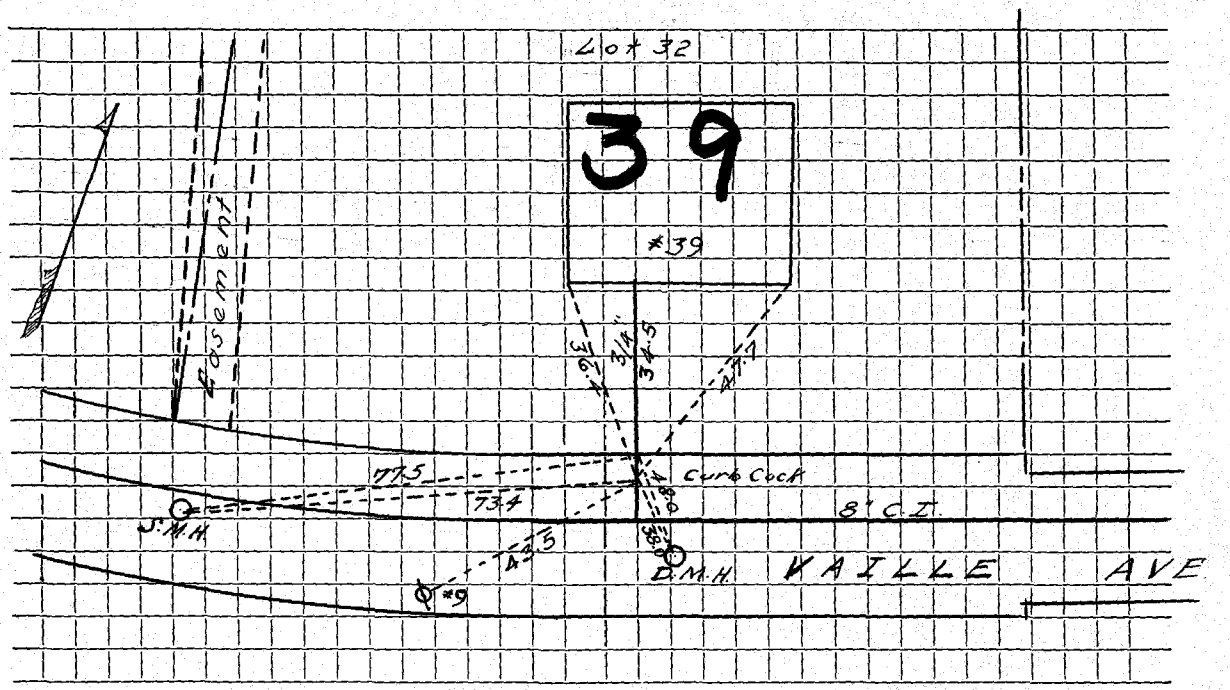

Connection made in ..... Street. Work completed .....

Remarks: .....

.....

.....