WATER SERVICE RECORD

Name **Service No.**

Address 63 Valley Road

Location Lot #24

Repair—Renewal—New Service McLaughlin - PERMIT NO. 0930

Date		Material	Amount		Total		Date			Amount	
3/11/97	35'	1" COPPER					3/11/97	30'	1" COPPER		
		1" VALVE							1" CURB		
									Buffalo Box		
									~~OUTSIDE~~		
							6/17/96		Tap & 1" Corp.	$ 50.00	
									CHARGE WHEN CONNT. JW		

DATE _____

TOWN OF LEXINGTON — BOARD OF PUBLIC WORKS

WATER DIVISION

Sketch of Service Here

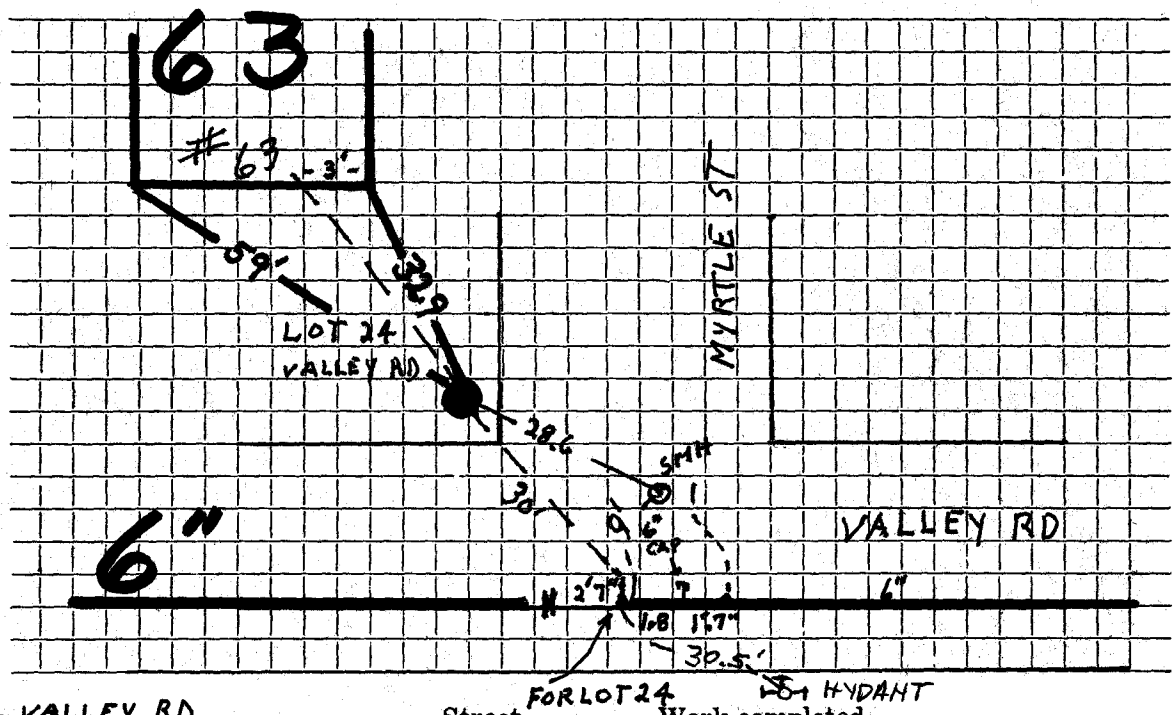

Connection made in VALLEY RD ..... Street. Work completed .....

Remarks: .....

.....

.....

BOOK 97-1