WATER SERVICE RECORD

Name **Service No.**

Address VALLEY RD

Location TENNIS CT.

Repair—Renewal—(New) Service BLOW OFF

Date		Material	Amount		Total		Date			Amount	
MAY 1996	3'	1" COPPER									
		1" CORP									
		1" Curb									
		Buffio Box									

DATE _____

TOWN OF LEXINGTON — BOARD OF PUBLIC WORKS

WATER DIVISION

Sketch of Service Here

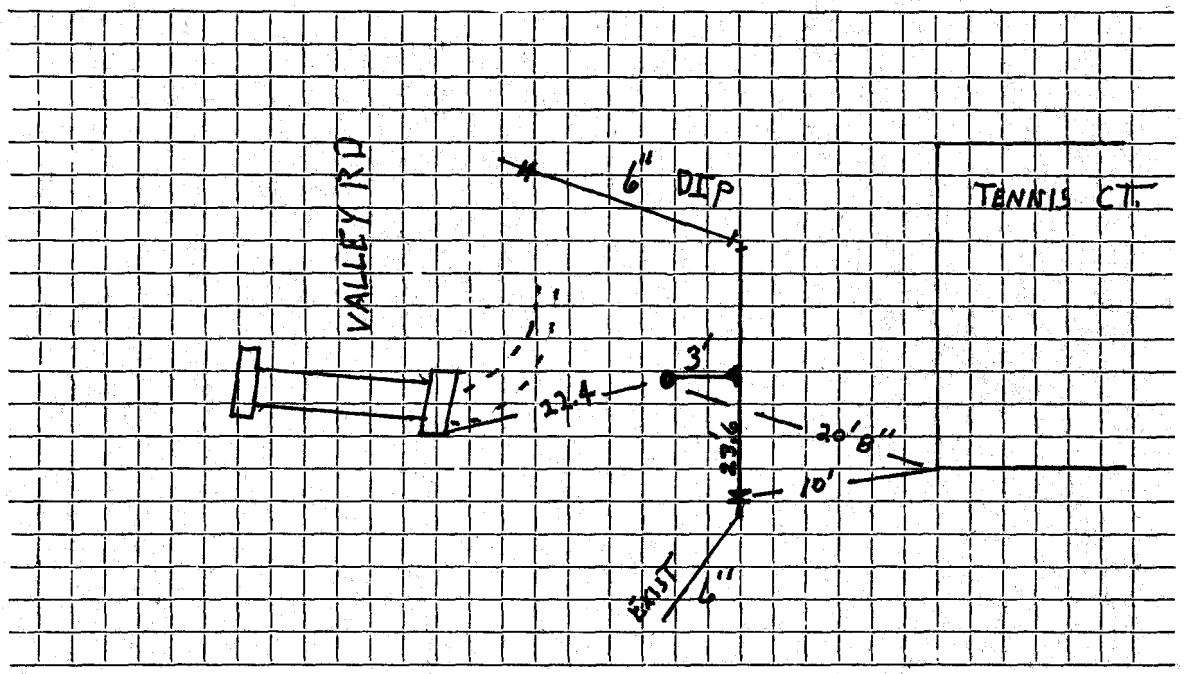

Connection made in ..... Street. Work completed .....

Remarks: COPPER BROKEN OFF AT GROUND LEVEL .....

.....

.....