H.B.M.16010

WATER SERVICE RECORD

Name Volunteer Assoc. Realty Trust **Service No.** 35

Address 74 Valleyfield Street

Location Sta. 11+43 Left - Lot #83

~~Repair~~ ~~Renewal~~ **New Service** W.O. #KY 5526
Lexington Sewerage #1111

AUG 5 1968

Date		Material	Amount		Total		Date			Amount	
7-15-68	31'	3/4" Copper tubing					3-15-68		Deposit	61	14
10/5/67		Labor	5	35							
		10% O.H.		54	5	89					
	43'	3/4" copper tubing @ .79			33	97					
	1	3/4" Curb			8	76					
	1	3/4" Corp			7	42					
	1	Box & Rod			5	10					
					61	14					

DATE _____

TOWN OF LEXINGTON — BOARD OF PUBLIC WORKS

WATER DIVISION

Sketch of Service Here

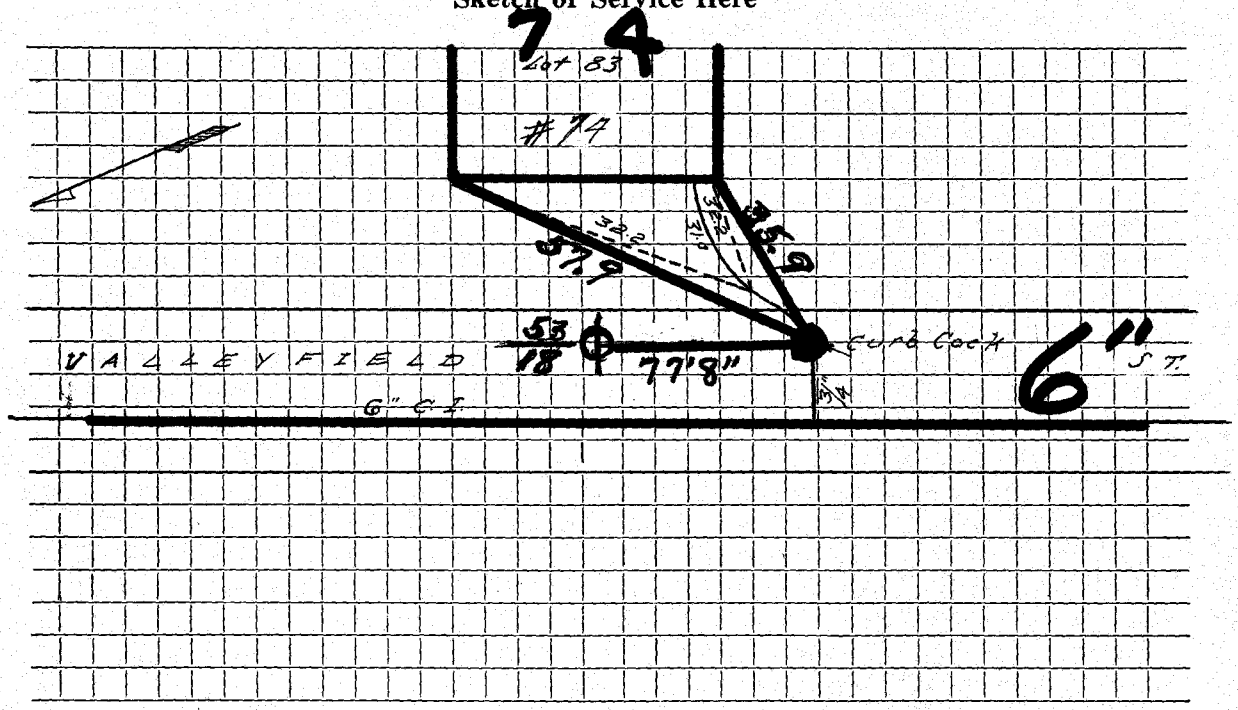

Connection made in ..... Street. Work completed .....

Remarks: .....

.....

.....