H.B.M.16C10

#6162
#9694

WATER SERVICE RECORD

Name

Service No.

Address 3 Village Circle

Location Lot #3 ~~Lucente~~

Repair—Renewal—New Service Lucente #1730

Date		Material	Amount		Total		Date			Amount	
11-3-70	40'	3/4" Copper tubing									
12/14/70	43'	3/4" Copper tubing									

DATE _____

TOWN OF LEXINGTON — BOARD OF PUBLIC WORKS

WATER DIVISION

Sketch of Service Here

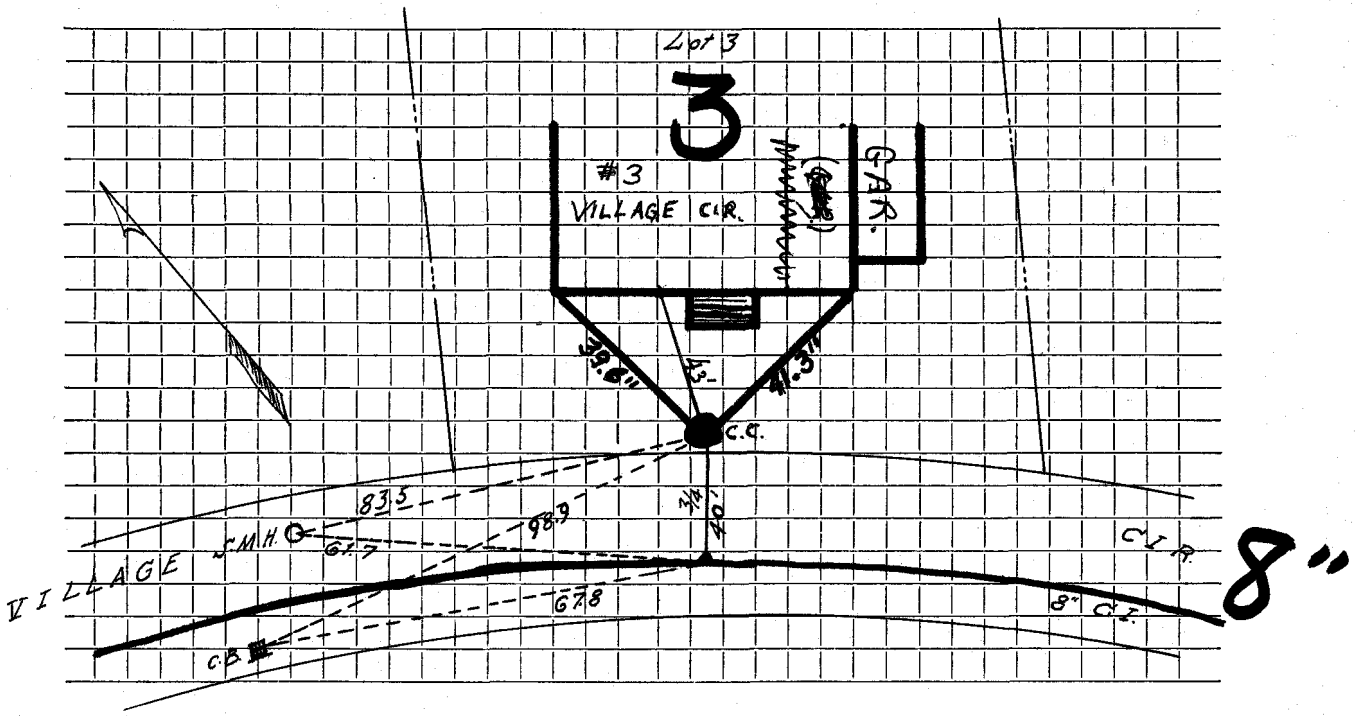

Connection made in ..... Street. Work completed .....

Remarks: .....

.....

.....