WATER SERVICE RECORD

Name **Service No.**

Address

Location 117 VINE ST

Repair—Renewal—New Service Jim McLaughlin

Date	Material	Amount	Total	Date	OUT	Amount
12/5/96	5T 1" C				1 1/2" Curb	
	1" CURB STOP				1 1/2" COPPER	
	1" VALVE				Buffalo Box	
CURB TO REDUCER	16' 1" C				1 1/2" CORP	
	1 1/2" X 1" REDUCER			6" x	1 1/2" SERVICE SADDLE	

DATE _____

TOWN OF LEXINGTON — BOARD OF PUBLIC WORKS

WATER DIVISION

Sketch of Service Here

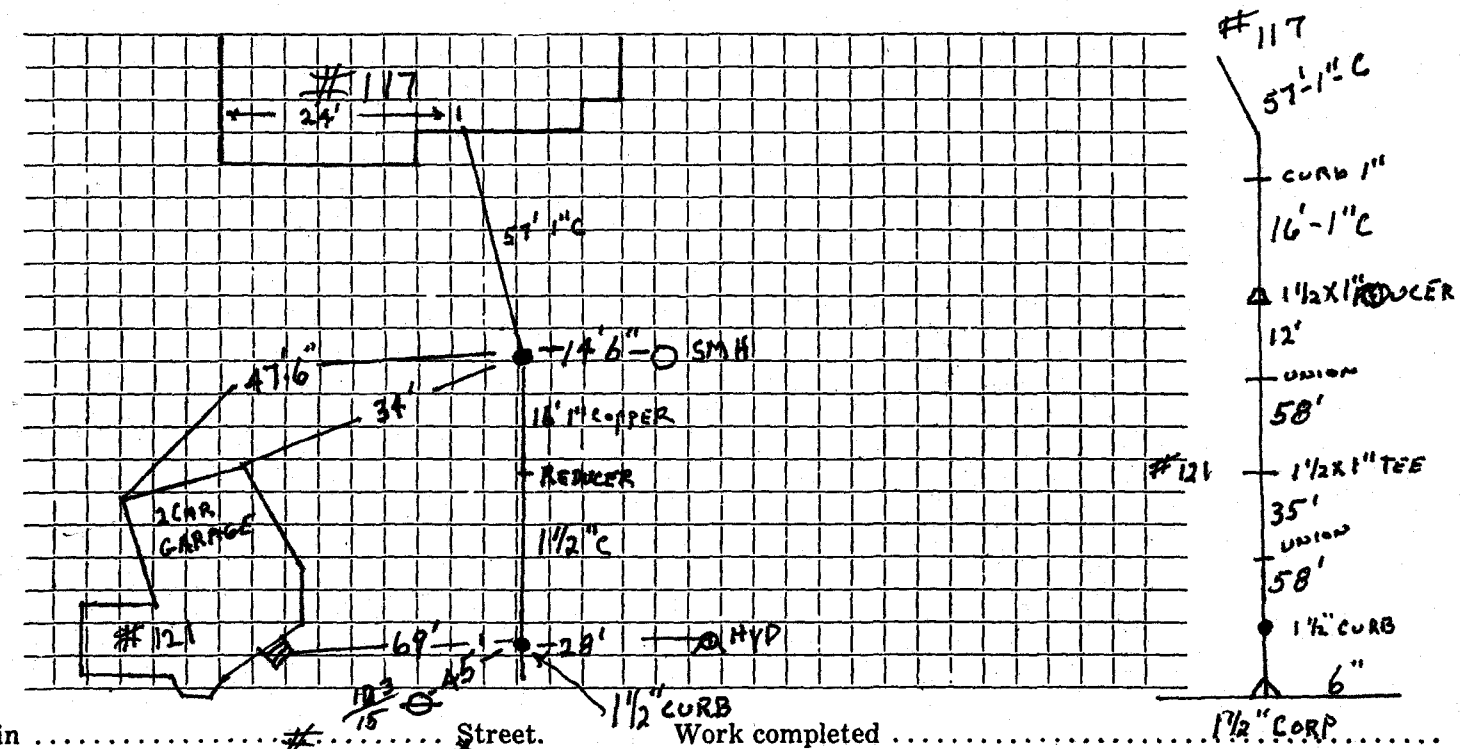

Connection made in ..... # ..... Street. Work completed .....

Remarks: 1 1/2" VALVE Shut off 117 AND 121