WATER SERVICE RECORD

Name *Robert Phelan* Service No.

Address [redacted] 41 WALNUT ST. LOT 14F1

Location

Repair—Renewal—New Service *Redmond #4619*

Date	Material	Amount	Total	Date		Amount
11/26/86	13 LF 1" COPPER					
	1" CORP.					
	1" CURB W/BOX					
11/16/87	10 1/2 LF 1" COPPER					
	1" UNION					

DATE _____

TOWN OF LEXINGTON — BOARD OF PUBLIC WORKS

WATER DIVISION

Sketch of Service Here

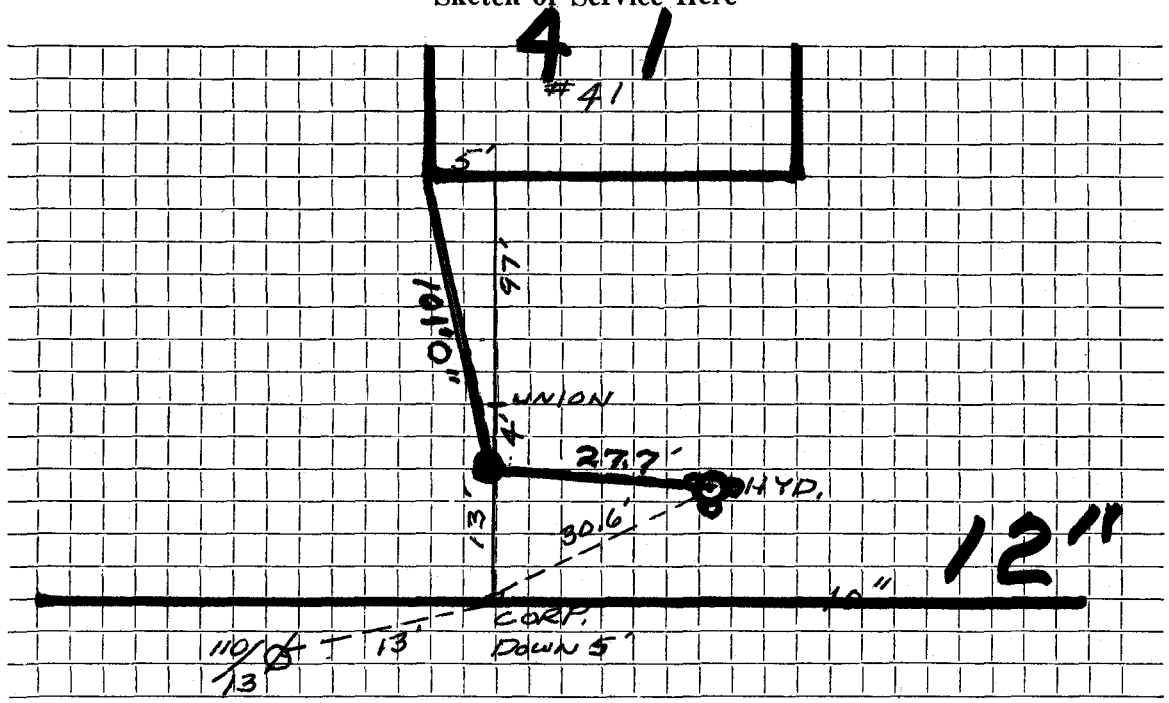

Connection made in WALNUT Street. Work completed .....

Remarks: .....

.....

.....